Addendum No. 02

Date: March 12, 2021

RE: University of Colorado Denver, Anschutz Campus
G3 Robotics Lab Renovation PN21-113546

Addendum Clarifications:
The attached addenda are provided to supplement the 100% For Construction documents dated 01/20/2021. Below is a list of updated sections and/or drawings.

Specifications

- 00107 – Seal Page – added AOR and EOR seals
- 007380 – Added City/County of Denver Tax Exemption Letter
- 230503 - Basic Mechanical Material and Methods
- 283100 – Fire Detection and Alarm

Drawings

- A201 – Robotics Room - added floor infill details
- A202 – Research – add window film material and sizes
- M001 – Mechanical General Notes – added note 8 under Fire Protection Notes
- M801 – Mechanical and Plumbing Details – revised note to clarify cylinder retainer provided by owner

ARCHITECT:
Hellmuth, Obata and Kassabaum, Inc. (HOK)
Grant Ramsey
Sr. Project Manager
Grant.ramsey@hok.com
(618) 9890-7666

DOCUMENT 000107 - SEALS PAGE

1.1 DESIGN PROFESSIONALS OF RECORD

ARCHITECT

1. Angelo Arzano
   ARC.00405309
   Divisions 01 - 12 except where indicated as prepared by other design professionals of record

ELECTRICAL ENGINEER

Leonard Gurule
38874
The Following Sections:
Division 26

HVAC ENGINEER

Brian Kannady
37026
The Following Sections:
Division 22 & 23

END OF DOCUMENT 00 01 07

CITY AND COUNTY OF DENVER

WELLINGTON E. WEBB
Mayor

DEPARTMENT OF REVENUE

TREASURY DIVISION
ANNEX III
144 WEST COLFAX AVE.
DENVER, COLORADO 80202
FAX: (303) 640-3868

November 5, 1999

University of Colorado Procurement Service Center
Fitzsimons Building 500 Rm. E4325
Mail Stop F 719
P.O. Box 6508
Aurora, CO 80045

Ladies/Gentlemen:

The University of Colorado Procurement Service Center is exempt from the Denver sales tax per Sec. 53-26 (1) of the City Retail Sales Tax Article:

> Sec. 53-26(1) Exemptions.
>
> There shall be exempt from taxation under the provisions of this Article the following: (1) All sales to the United States Government, to the State, its departments and institutions and the political subdivisions thereof, only when purchased in their governmental capacities.

To qualify for the exemption, purchases must be billed direct to the organization, and payment made from funds of the organization.

The exemption does not extend to construction contractors who may perform contracts for you; they are the consumer of all property purchased and used in the performance or contracts for others. Nor does the exemption apply to purchases by employees or members for their own personal use.

You may reproduce this letter to furnish to suppliers as needed.

Sincerely,

Scott Sprague, Audit Manager
Tax Compliance/Audit Section
(303) 640-3484

DR 0160 (02/06/07)
COLORADO DEPARTMENT OF REVENUE
DENVER CO 80261-0013

CERTIFICATE OF EXEMPTION FOR COLORADO STATE SALES/USE TAX ONLY

THIS LICENSE IS NOT TRANSFERABLE

USE ACCOUNT NUMBER for all references	LIABILITY INFORMATION	ISSUE DATE
98-02565-0000	01 006 G 010180	DEC 01 2008

633 17TH ST 15TH FLR DENVER CO

STATE OF COLORADO CONTROLLERS OFFICE
633 17TH ST 15TH FLR
DENVER CO 80203

Executive Director
Department of Revenue

NEW AUTOMATED SERVICES FOR AND ABOUT BUSINESSES

The Colorado Department of Revenue Sales Tax Information System provides the following automated services:
* Colorado Sales Tax Rates - find specific city, county and special district rates.
* Verification of Sales Tax License Exemption Numbers - determine whether a Colorado sales tax license or exemption certificate is valid.
* Tax Rates by Account Number - find sales tax rates and locations for specific sales tax accounts.

These services make it possible for taxpayers to help themselves to information 24 hours a day - without requiring the assistance of a customer service representative. In this way, more complicated or confidential tax information inquiries can be reserved for speaking to a live agent.

Listen and look for these services on the department's business tax information phone line at 303-238-FAST (3278) for specific account information, 303-238-SERV (7378) for general information or the DOR Web site at www.taxcolorado.com

Web users can try the new system online at www.taxview.state.co.us We are interested in your comments about the system. You can send us an e-mail with your comments through our Department of Revenue Web site.

SECTION 230503 - BASIC MECHANICAL MATERIALS AND METHODS

PART 1 - GENERAL

1.1 RELATED DOCUMENTS

A. This Section supplements Division 1, General Requirements.

B. Where contradictions occur between this Section and Division 1, the more stringent of the two shall apply. The Architect design team shall decide which is most stringent.

C. Provisions of this Section shall also apply to all Sections of Divisions 21 through 23.

1.2 SUBMITTALS

A. Manufacturer's Data - Submit manufacturer's data for:

1. Access panels.
2. Fire stopping materials.

B. Application Data - Submit application data for firestopping materials showing UL required installation details for every combination of pipe material, penetrated structure, opening size and required fire rating within the scope of this project. Application data drawings shall include UL system number.

PART 2 – PRODUCTS

2.1 ACCESS PANELS

A. See Division 8 for access panel types and finishes.

1. If panels are not specified in Division 8, comply with the following:
   a. Manufacturers:
      1) Design Basis: Milcor Division, Inryco, Inc.
      2) Other Acceptable Manufacturers:
         a) Birmingham Ornamental Iron Co.
         b) Karp Associates, Inc.
         c) Wilkenson Co., Inc.
         d) Zurn.

B. Construction:

1. Doors: 14 gauge steel.
2. Frames: 16 gauge steel.
3. Fire Rating: Equivalent to construction in which installed.

4. Latches: Flush or concealed, ¼ turn, screwdriver slot.
5. Finish: Compatible with finish of construction in which installed.

2.2 FIRE STOPPING MATERIAL

A. Manufacturers:
   1. Design Basis: 3M.
   2. Other acceptable manufacturers:
      a. GE
      b. Metalines
      c. Hilti

B. General Requirements:
   1. Products to be used shall have been tested in accordance with ASTM E 814-88, and be listed in the UL Fire Resistance Directory.

C. Bare Piping:
   1. Model: FD 150, or CP-25.

D. Insulated Piping:
   1. Model: CP-25 or FS-195, Intumescent.
   2. “No-sag” or “self-leveling” as required.

E. Plastic Piping:
   1. Model: CP-25 or FS-195, Intumescent.
   2. “No sag” or “self-leveling” as required.

F. Accessories:
   1. Provide fasteners, restricting collars, backing materials, and protective coatings as required to comply with the UL system listing.

PART 3 – EXECUTION

3.1 CUTTING AND PATCHING

A. Refer to Division 1 of the Specifications.

B. General: Provide measurements, drawings and layouts to installers of other work so that required openings may be provided as construction progresses. Any cutting and patching made necessary by failure to provide this information shall be done at no increase in the contract amount. Any cutting and patching required as part of the project shall be included in the bid and shall not be an increase in the contract amount.

C. General: All cutting and patching of existing work required for work of Divisions 21 through 23 is included in Divisions 21 through 23.

D. Where possible, mark openings to be cut on existing construction. Otherwise, provide measurements, drawings and layouts to the trade doing the cutting so that openings may be provided as construction progresses.

E. Cutting Concrete:

1. Where authorized, cut openings through concrete for penetrations by core drilling or sawing. All openings shall be approved by Structural Engineer.
2. Do not cut by hammer-driven chisel or drill.

F. Cutting:

1. Cut openings in accordance with layouts, measurements or drawings of the Installer of work requiring openings.
2. Coordinate the location of all openings with structural drawings. Report any discrepancies to Architect. Do not proceed with work until discrepancies have been resolved.
3. Do not endanger or damage other work through the procedures and processes of cutting to accommodate mechanical work.
4. Review the proposed cutting with the Installer of the work to be cut, and comply with his recommendations to minimize damage.
5. Where necessary, engage the original Installer or other specialists to execute the cutting in the recommended manner.

G. Patching:

1. Where patching is required to restore other work because of either cutting or other damage inflicted during the installation of mechanical work, engage experienced craftsmen to complete the patching of the other work.
2. Restore the other work in every respect, including the elimination of visual defects in exposed finishes.
3. All openings in fire rated construction shall be patched and sealed with U.L. approved sealant to maintain the fire integrity of the structure.

H. Perform cutting, and patching required to:

1. Uncover work to provide installation of ill-timed work.
2. Remove and replace defective work.
3. Remove and replace work not conforming to requirements of the Contract Documents.
4. Remove samples of installed work as specified for testing.
5. Install equipment and materials in existing structures and ceiling spaces.
6. Upon written instructions from the Architect/Engineer, uncover and restore work to provide for Architect/Engineers observation of concealed work.

I. Painting: Paint all surfaces marred by cutting and/or patching to match existing.

1. Engage experienced painters.
2. Comply with requirements of Painting Sections of this Specification.

J. Structural Limitations:

1. Do not cut or drill into structural framing, walls, floors, decks, and other members intended to withstand stress, except with Engineer's written authorization.
   a. Provide lintels, columns, braces and other temporary and permanent supports made by cutting.
   b. Submit shop drawings of permanent supports.
   c. Do not penetrate legs of structural "T's" or any other location where pre-stressed structural chords are likely to be encountered when cutting or drilling.

3.2 ACCESS PANELS

A. Furnish access panels where indicated and at locations where required for access to:

1. Concealed valves
2. Dampers
3. Control devices
4. Equipment servicing
5. Air vents
6. Flow measuring and balancing stations
7. Any other device or item equipment requiring maintenance, adjustment or service.

B. Deliver access panels for installation by the trade responsible for surface in which installed.

1. Provide instructions for location.
2. The minimum size for access doors shall be the larger of 18"x18" or to fit the size of equipment to be removed.

3.3 FIRE STOPPING

A. Install firestopping materials in accordance with their UL and ASTM tested methods.

B. Coordinate required annular space with size of pipe and sleeve. Refer to Section 23 05 22.

C. Requirements for specific systems:

1. Cold piping - includes chilled water, domestic water, storm water and refrigerant: Insulation and vapor barrier shall be continued through wall and firestopping for "insulated piping" shall be provided.

2. Hot piping - to 250ºF -includes domestic hot water, steam to 15 psig and heating hot water: The Contractor has the option of continuing the insulation through the penetration and providing firestopping for “insulated piping”, or stopping the insulation on either side of the penetration and using firestopping for “uninsulated piping”.

3.4 EQUIPMENT SUPPORTS

A. Supporting Steel: Provide supporting steel not indicated on the Structural Drawings for equipment, pipe, ductwork, and other pieces of this Division’s work requiring same.

1. Submit registered Structural Engineer calculations and shop drawings to Engineer for record and comment.
2. Fabricate supports in accordance with AISC Specifications for the Design, Fabrication and Erection of Structural Steel for Buildings to meet 2012 IBC.
3. Brace and fasten with flanges bolted to structure.
4. Paint supporting steel with one coat of primer paint in the shop after fabrication welding is complete. Paint completed field joints with one coat of matching primer.

3.5 DRIP PANS

A. Drip Pans: Where possible to run mechanical piping elsewhere, do not run mechanical piping directly above electrical (or electronic) work which is sensitive to moisture. Otherwise, provide drip pans under mechanical piping, sufficient to protect electrical work from dripping.

1. Locate pan immediately below piping, and extend a minimum of 6” on each side of piping and lengthwise 18” beyond equipment being protected.
2. Fabricate pans 2” deep of reinforced sheet metal with rolled edges and soldered or welded seams; 22-gauge galvanized steel.
3. Provide ¾” copper drainage piping from pan to nearest floor drain or similar suitable point of discharge, and terminate pipe as an open-sight drainage connection.
4. Provide permanent support and anchorage to prevent displacement of drip pans.
5. Insulate bottom of pan as directed by Engineer.

END OF SECTION 230503

SECTION 28 31 00 - FIRE DETECTION AND ALARM

PART 1 - GENERAL

1.1 DESIGN REQUIREMENTS

A. Provide a microcomputer based system using multiplex techniques for alarm reporting, central monitoring, signaling, and selection of audible and visual signal circuits. The fire alarm system should be capable of making emergency announcements. The fire alarm subcontractor should work closely with the campus Information technology department working through the University Project Manager to make this work.

B. Provide individually identified fire alarm sensors; pull stations, indicating devices, and compatible monitor and control devices. Provide a unique address for each device 8 digit only, with operator-assigned English language descriptor.
   1. The system shall include the following major components
      a. Fire Alarm Control Panel
         1) CU Anschutz buildings – Edwards EST3
         2) CU Denver buildings – Edwards EST3
         3) CU Denver buildings on Auraria Higher Education Campus – Verify with Project Manager.
      b. Fire Alarm Annunciator Panel (FAAP) and LCD Display.
      c. Fire Alarm Voice/Evacuation Panel (FVEP)
      d. Fire Alarm Computer Terminal (FACT) – FACT refers to the individual building and University Police Building FACT.
         4) CU Anschutz buildings – FireWorks
         5) CU Denver buildings – FireWorks for Edwards fire alarm systems
         6) CU Denver buildings on Auraria Campus – Verify with Project Manager.
      e. Fireman Two Way Telephone Panel (FTP) – If required by the building type.
      f. Digital Alarm Communicator Transmitter (DACT) (3-Mod Comp)
      g. Interface with campus overhead Emergency Paging system with Central Station monitoring computer controls.
   2. Conventional fire alarm initiating devices (smoke detectors, heat detectors, manual stations, water flow and tamper switches, pressure switches) shall each be individually addressable via, and shall report to the FACP.
   3. Control relays shall be individually commanded by the system to respond automatically in case of an alarm by related sensors or other devices. Manual control of fans, dampers and required relays shall be provided, as well as automatic control where required by code. Control sequences shall be as indicated on related mechanical systems control drawings.

C. The system shall operate as a low voltage, zone-annunciated Fire Management System and shall include the following subsystems:
   1. FACP to monitor addressable initiating and control devices, annunciate the alarm device exact location, initiate alarm and evacuation signals, and capture and recall elevators.
   2. FACP and Associated Auxiliary panels shall be provided with Class “A” wiring.

D. Provide UL listed system. If required as a condition requisite to establishing UL listing of the entire installation as a system, the Contractor shall arrange for, and pay all costs associated with, any required off-site or on-site review, supervision, and/or inspection which may be required for gaining such UL listing.

E. Conform to the following NFPA requirements:
   1. Initiating Device Circuits (IDC) shall be Class B
   2. The Signaling Line Circuits (SLC) shall be configured as follows:
      a. Class A for signaling line circuits connecting intelligent devices to the FACP.
      b. Loss of connectivity between FACP and the facility's Central Control FACP shall not hamper functions of the fire alarm system within the building.

3. The Notification Appliance Circuit (NAC) shall be Class B

F. ANSCHUTZ MEDICAL CAMPUS SYSTEM LAYOUT
1. General:
a. All campus buildings will be equipped with a FACP. Locate near the main entry and a FVEP located near the FACP per the building design, for all non high-rise buildings.
b. Each FACP shall be networked into the campus network and accessible from the Campus FACT. Any FVEP shall be accessed from the Campus FCC FVEP microphone and/or the Campus Police Station FVEP microphone.
c. One FACP and FACT in one university high-rise building FCC and one university high-rise building FCC will be designated alternate locations for the Campus FCC FACP. All information residing in the FACP/FACT of the Campus will be duplicated at these two locations.
d. A FACT with FAP or a FAAP with LCD indicating building in alarm shall be located at the University Police Building. The Police Station shall be capable of accessing any FVEP via local microphone.
e. Every building will be equipped with a weatherproof speaker/strobe located at each exterior door.
f. Include the Following Front Panel Controls:
1) Each floor shall have a disable button
2) Elevator disable
3) Fan/shut-down disable
4) Pager disable
5) Door disable
6) Separate speaker and strobe disable
7) Manual page by floor
8) NETCOM DISABLE
9) BAS DISABLE

G. Provide interface with the Building Automation System to report all “alarm” and “supervisory” actions. Refer to Division 23.

1.2 PERFORMANCE REQUIREMENTS

A. General:
1. Normal operator interface, through the FACP located in each individual building where required, and at the designated FACT located in the Anschutz Medical Campus University Police Building in the Police Dispatch. All system early-warning pre-alarm, alarm, and trouble messages shall be annunciated on the FACT in a color-graphic format with English language descriptors.

B. High-Rise Buildings.
1. The fire alarm sequence of operation shall be in accordance with the requirements for high-rise buildings, including but not limited to the following:
a. The alarm and activate the strobes for the floor in alarm and the floors above and below.
b. Initiate stair pressurization and where used, initiate pressurization of the floors above and below the floor in alarm.
c. Release of stair, held-open doors, and re-entry doors.
d. Upon activation of the elevator, elevator shafts, or elevator lobby detectors, recall the elevators to the main exit level or alternate floor.
e. Activate refuge area communications link.
f. Annunciate the alarm to the building FACP, and FAAP, and to University Police FACT.
g. Annunciate the alarm condition and location to the building FAAP and local floor FAAP.
2. The Command Center of the High Rise Buildings shall also be equipped, under another contract, with the following remote status/control panels:
a. Buildings electrical distribution system.
b. Building fire pump.
c. Elevator status and control panel.

d. Building voice paging system and/or voice evacuation system (i.e., Office Building) via zone interface panel and microphone.
e. CCTV system monitors and keyboard.
f. Smoke control panel.
g. Generator control panel.

3. The FD will use these panels for viewing or controlling each of the above systems.

C. The FD will respond to the FACP of the building in alarm and to the Campus Police. The Campus Police FACT shall be automatically activated into the graphics mode to show the current status of all devices in alarm. The FD will take command of the Building's FACT to monitor the current response to the fire alarm condition. Using a "mouse driven" graphic menu, the FD shall be able to "zoom in" or "zoom out" of the graphic screens to view the current alarm condition.

1. The FD will use the building's FCC PC graphic system to view and control the response of the fire alarm system by viewing special graphic screens such as:
   a. A smoke control system status and control screen.
   b. Any building within the complex connected to the fire alarm system.
   c. Any preprogrammed screen existing within the fire alarm system.
   d. Or other specialty screens that may be created at the request of the university Facilities Operations.
2. Using the assigned FD Identification Code (ID password), the FD may use the FCC PC to alter the preprogrammed fire fighting response to the present alarm condition. A printer will provide hard copy documentation of all alarm conditions, ID password log on commands, and the system response to the specific fire alarm condition.

D. The Campus Control Center fire alarm computer will provide monitoring and secondary back up of the fire alarm computers located in the various fire command centers. If an equipment trouble alarm is initiated from a fire alarm device, it shall be reported at the FCC FACP of the building in alarm and the Campus Control Center PC.

E. If a fire alarm condition is received and the FD cannot initiate an appropriate response from the building's FCC PC (i.e., fire in the Buildings' FCC room, or a failure of the FCC PC), then an override ID password command can be used by the FD to make any system PC the primary PC for the manual fire fighting override response. The selected PC shall be able to alter a building's preprogrammed response to the alarm condition. The selected PC shall be able to access and control all PC graphic screens that reside within the system.

F. It shall be possible for all authorized personnel, using the proper ID password, to place the facility into smoke control operation through the graphic screens from the University Police (FACT), or the Building's FCC FACP.

G. Automatic Actions:

1. Activation of an alarm-initiating device, as specified herein shall cause the following:
   a. Annunciation of the alarm condition, type, and device address at the FACP, FACT and FAAP in a LCD format at the building FAAP. An audible signal shall sound and the alarm condition shall flash until acknowledged. The alarm condition and its location shall also be displayed at the University Police FACP, FACT, and FAAP per the building design.
   b. The appropriate audio and visual alarms shall be transmitted throughout the building in alarm or to predetermined zones of the building in alarm.
   c. Disable the elevator call system and recall the elevators to the level of discharge exit or to the alternate floor.
   d. Initiate smoke control procedures and functions automatically (position dampers and control fans) from the building FACP.
   e. Release self-closing fire and smoke doors in specified control zone when the system goes into alarm.
   f. Provide control relay at each access control panel to unlock all secured doors in activated control zone.

University Project Manager.

2. Provide smoke detector circuits with alarm verification with field-adjustable time from 0 to 60 seconds. Only verified alarms shall initiate the specified sequences.
3. Activation of a sprinkler valve supervisory switch shall initiate supervisory alarm at the corresponding building FACP, FAAP, FACT, and FAP and initiate a supervisory alarm signal at the University Police FACT. Supervisory alarms shall be differentiated from a trouble condition on the circuit.
4. A break in the initiating circuit or detector power wiring shall be annunciated as a trouble condition on the building FACP and the University Police FACT.
5. A break in the audio/visual circuit wiring shall be annunciated as a trouble condition on the building FACP and the University Police FACT.

H. Failsafe Operation: To increase the system's ability to survive damage from fire, malicious or accidental damage, premature component failure, etc., the fire alarm system shall provide the following functionality:
1. Each building FACP shall operate in a stand-alone manner, independent of any other FACP or FACT. The building FACP shall contain the complete data file for all connected devices, regardless of the building, and shall operate the same way whether connected to any other FACP or FACT. This includes:
   a. Annunciation of device address and condition. One hundred percent of all connected devices shall be capable of operating for alarm simultaneously.
   b. Logical Point Grouping annunciation and control. Each Logi-cal Point Group shall contain up to 15 physical points and shall be capable of initiating a sequence of control actions.
   c. Event-initiated control, signaling and/or annunciation sequences. One hundred percent of all connected devices shall be capable of being operated simultaneously.
   d. Priority display of multiple alarms.
   e. Complete supervision of all connected devices with no degraded operation.
   f. Complete reset capabilities at FACP and FACT.
2. Standby batteries capable of operating the FACP, FACT (except those supported by non-interruptible power supply systems), FAAP, FVEP, smoke detectors and alarm horns, strobes, secondary PC terminals, video display units and printers, shall be provided to automatically back up the emergency power source. The system shall have the capacity to operate FACP, as required per NFPA PCs for two hours, and then operate the fire alarm indicating devices for at least 15 minutes, per NFPA requirements. When commercial power is restored, the system shall transfer automatically to primary power. System power supply shall be equipped with battery charging circuits sufficient to recharge fully depleted batteries to within 70 percent of their maximum capacity within 12 hours.
3. System operating software and data file shall be resident in nonvolatile memory. Loss of power, momentary or for a sustained period shall not require reloading of the software.
4. All plug-in circuit boards shall be electrically supervised to assure that the proper board is in the proper position. Systems that use electrical continuity to supervise the presence of plug-in boards, but that do not assure that board positions have not been exchanged, shall provide additional means for the specified supervision, beyond that provided by locking covers.
5. The FACT shall be provided with battery backup or individual dedicated UPS.

I. Color code and minimum wire sizes for the fire alarm system as follows:
1. All wire is solid copper:
2. All insulation colors shall be continuous for the full length of the wire.

3. Wire Jackets shall be stamped with the "Circuit Type" designation or shall have an affixed label designating the "Circuit Type" every twenty lineal feet at a minimum.

Circuit Type	Colors		Size
	Wire	# Of Conductors	
Initiating Circuits	(+) Red (-) Black	2	18 (THHN)
Signaling Circuits	(+) Red (-) Black	2	16 Twisted
Speaker Circuits	(+) Orange (-) Brown	2	14 Twisted
Strobe Circuits	(+) Yellow (-) Blue	2	14 Twisted
Fire Fighter Phone Circuit	(+) Red (-) White	2	14 Twisted/ Shielded
Fire Fighter Phone Riser Circuit	(+) Red (-) White	2	14 Twisted/ Shielded
RS-485 Circuit	(+) Blue (-) Gray	2	16 Twisted
Damper Control	(+) Red (-) Black	2	14 THHN
AHU Shutdown Circuit	(+) Red (-) Black	2	14 THHN
24VDC Power Circuit	(+) White (-) Black	2	14 THHN
Fire Alarm Remote Light Circuit	(+) Red (-) Black	2	18 THHN
Speaker Phone Cut Out Circuit	(+) Orange (-) Brown	2	14 Twisted
Low Level Audio Riser Circuit	(+) Red (-) Black	2	14 Twisted/ Shielded
High Level Audio Riser Circuit	(+) Red (-) Black	2	14 Twisted
Door Holder Circuit	(+) Red (-) Black	2	14 Twisted

J. Intelligent Features:
1. The following additional features shall be provided:
   a. The fire alarm detector cleaning shall be annunciated at the FACP as a trouble condition by the device.
   b. Dual Alarm threshold for day or night settings.

K. Interface With Other Systems:
1. Interface design of fire alarm system with closed circuit television (CCTV) system and FO signal transmission system.
2. The Electronic Security Department (ESD) will provide software to interface with the CCTV and fire alarm systems. CCTV and fire alarm manufacturers shall provide software protocol, for their systems, to ESD.
3. Consultant may purchase copy of specifications for interfacing systems from the university for the purpose of determining interfacing requirements.
4. Interface voice notification with the campus RAV system.

1.3 SUBMITTAL

A. Provide shop drawings as follows:
1. Floor plans with device layout, address and wiring.
2. FACP layout.
3. Riser diagrams.
4. Battery calculation.
5. Sequence of operation
6. Equipment cut sheets
7. FAAP layout.

B. CADD generated layouts for FACT screen graphics.

C. Operating and Maintenance Manuals.

D. Project Record Documents:
1. Prior to submittal of the as-built documents, submit a complete package of shop drawings to the university Facilities Operations Fire and Safety office for review. Drawings shall include floor plans and graphic maps for each building and/or floors.
2. Submit record documents in accordance with the requirements of Section 01 78 39 and the following:
a. As-built point-to-point wiring diagrams depicting every device, including correct university room numbers.
b. Revised schematic, wiring, and interconnection diagrams of all circuits, internal and external, for all equipment installed and exact locations for all devices. These schematics shall include the conductor color-coding and terminal number identification system, location of all terminal boxes complete with numbering and each device address.
c. Complete, as-installed, riser diagrams indicating the wiring sequence of all alarm initiating devices, supervisory devices, and all signaling appliances on all signaling circuits.
d. A complete description of the system operation, including a schedule of relay abbreviations used on the drawings, list of relay functions, and the sequence of relay operation during supervisory trouble and alarm conditions.
e. Complete wiring and control diagrams for control and shutdown circuits for fan systems.

1.4 QUALITY ASSURANCE

A. Manufacturer: Company specializing in Intelligent Fire Management Systems.

B. Installer: Company with certified personnel specializing in smoke detection and fire alarm systems with five years' documented experience as a fire alarm installing contractor.

C. Fire Management system installer shall keep all smoke heads in the building covered until final building turn over. Failure to comply will mandate a complete cleaning of the individual heads on the system.

PART 2 - PRODUCTS

2.1 MANUFACTURERS

A. Edwards System Technology (Sole Sourced)

2.2 APPROVED INSTALLERS

A. ADT, Rockies Life Safety Division, 6510 Franklin Street, Denver, CO 80229, (720) 826-5923

B. Convergint – 7330 S. Alton Way, Suite 12K, Centennial, CO (303) 932-0757

C. Fire Alarm Services, Inc – 4800 West 60th Avenue, Arvada, CO 80003 (303) 466-8800

D. Meridian Fire and Security – 7173 S. Havana St Ste 400 Centennial CO, 80112 (303) 790-2520

E. Other Edward System Technology installers will be considered if they have successfully completed 3 similar projects (in size and complexity) in the past 5 years in the Denver Metro area and NICET certified. Installer must demonstrate ability to provide ongoing service to any system it installs. Other installers must be approved in writing by the University Project Manager prior to bidding on the project. University approval takes 5 business days.

2.3 MATERIALS, GENERAL

A. All equipment and materials used shall be standard components, regularly manufactured, and regularly utilized in the manufacturer's system.

B. All systems and components shall have been thoroughly tested and proven in actual use.

C. All equipment shall be listed and labeled by Underwriters Laboratories.

D. All sensors shall be of the intelligent type and shall mount on a common base. This base shall be incompatible with conventional detectors.

E. Where equipment of different manufacturers is used, such equipment shall be included under the required over-all UL system listing as a component of the integrated fire alarm system.

F. The system shall be designed to operate with unshielded wire, to the maximum practicable extent. Shielded wire may be used. FO cable shall be utilized, as required or as indicated by the design documents.

G. FACPs shall be provided with tamper switches on cabinet doors to protect against unauthorized access to internal devices. The panel shall provide commandable outputs, which can operate relays or logic level devices.

H. Memory data shall be contained in EEPROM non-volatile memory. If non-volatile battery-backed RAM provides memory, removal of the board shall not cause loss of memory contents. I. The Fire Alarm annunciator panels shall be LCD types.

J. Site Specific Customizing Software:
   1. General:
      a. Provide software and Programs with technical support and training for the university's Facilities Operations staff during installation of system and completion.
      b. Alarm display shall include, as a minimum:

1) Indication of alarm condition, i.e. ABNORMAL OFF, HI ALARM/ LO ALARM, analog value or status, and English group and point identification such as "SMOKE DETECTOR BUILDING “A” - 2ND FLOOR- ROOM 202".
2) A discrete per point alarm action taking message, such as "CALL MAINTENANCE DEPT. EXT 5561", of up to 480 characters.

c. System shall automatically transmit alarm and troubles to selectable university pagers via a commercial carrier such as "AT&T Wireless".

d. The network routing properties for a panel's common controls determine which panels will respond when an operator presses the corresponding control command switch (Reset, Alarm Silence, Panel/Trouble Silence, Drill, Alternate Sensitivity) on the 3-LCD module.

Only the panels defined in the selected network routing group will respond to the command. Any building connected by a bridge or other structure shall annunciate to its opposite number(s) alarm, supervisory, and trouble conditions via single LEDs on its front panel.

2. Point summary reports:
   a. Point summary reports shall include the current value/status and condition.
   b. Trend reports shall allow the operator to randomly select logical arrays of points.
   c. Dynamic trends shall provide up to six points and show real time activity of the associated points.
   d. Alarm reports shall be automatically issued.
   e. A custom report capability shall be provided to allow the user to format reports of any mix of text, points with status/value and descriptors, and points with status/value only.

K. Fire Alarm System Devices:
1. General:
   a. Each device shall be assigned a unique address, 8 digit only Example (01020001). Address selection by jumpers is not acceptable. Devices which take their address from their position in the circuit are unacceptable. It is preferred that the address of the intelligent device be part of the device base rather than the device itself.
   b. Devices shall receive power and communication from the same pair of wires. For fault-tolerant circuits, any separate power wiring shall also be made fault-tolerant.
2. Analog Sensors (Photoelectric and Thermal):
   a. Each sensor shall contain an LED, which blinks each time it is scanned by the FACP. The sensor LED is to remain illuminated to indicate alarm. All sensors not visible from the corridor shall have a remote light mounted in the corridor as shown on the drawings.
   b. Each sensor shall be capable of being tested for alarm via command from the FACP or FACT. The values of the sensor shall be displayed at building FACP and FACT, and the University Police FACT.
3. Monitor Modules:
   a. The Monitor Module shall provide an addressable input for N.O. or N.C. contact devices such as manual stations, water-flow switches, sprinkler supervisory devices, door contacts, intrusion detectors, etc.
   b. The Module shall mount in a standard electrical box.
4. Control Modules:
   a. The Control Module shall provide an addressable output for a separately powered alarm-indicating circuit or for a control relay.
   b. The relay contacts shall be SPST (Form "C" rated at 2 amps at 28V DC).
   c. The module shall mount in a standard electrical box.
   d. Control voltage’s connected to intelligent control relays shall not exceed 24VAC/24VDC. Isolation relays shall be used on control voltages on excess of 24VAC/24VDC.
5. Fault Isolator Module (only if approved by the University Project Manager):
   a. The Fault Isolator Module shall detect and isolate a short-circuited segment of a fire-alarm loop.
   b. Modules shall be placed on every floor to limit the number lost addressable devices in case of a short-circuit on the intelligent circuit.

6. Intelligent manual pull stations shall be double action is typical on campus, mounted on standard electrical box. a. For public places, use single action pull stations with "Stopper II" cover.
7. Magnetic door holders shall be wall- or floor-mount on a standard electrical box.
8. Linear beam smoke detectors shall have cross-zone capabilities and be provided where shown on the drawings. Detectors shall consist of a transmitter and receiver unit utilizing infrared light to detect smoke between the units. These detectors shall have discriminating circuitry to differentiate between actual smoke, momentary blockage of the beam, and long-term blockage.
    a. Contractor shall provide a weatherproof enclosure for each pair of devices, utilizing transparent panels to allow light transmission. Ensure range of detector is adequate to compensate for passage through this glass.

L. Other Devices:
1. Speaker/Strobes:
    a. Strobes shall be synchronized.
    b. The speaker shall provide for minimum sound level of 95 dBA at 10 feet.
2. Analog Air Duct Detectors:
    a. Duct detectors shall be mounted exterior of duct with air sampling tube. Program duct detectors for supervisory indication only.
    b. Provide fire alarm remote light red LED, mounted on a standard plate fitted to a standard electrical box. When device is not visible, labeled plate with the name of the device served.
    c. Fire alarm remote light/test switch combination shall be utilized for each duct detector. The device shall have a red LED and two positions test switch mounted on a standard plate fitted to a standard electrical box. Plates shall be labeled with the name of the equipment served.
3. Tamper Switches: Installed under Division 21.
4. Flow Switches: Installed under Division 21.
5. Sprinkler Pre-action Solenoid and Deluge Valves: Installed under Division 21
6. Differential Pressure Switch: Installed under Division 23.
7. Damper End Switches: for damper position indication. Installed, under Division 23.
8. Relays provide addressable control and/or monitor module for each device indicated in paragraphs P. 3, 4, 5, 6 And 7 above. Include wiring to the device and to the fire alarm loop as required.
9. Provide control relays as required to accomplish functions such as fan shutdown, damper positioning, door release, etc.
10. Fire/Smoke dampers and smoke dampers will be provided under Division 23. The 24V wiring, including low voltage transformer P.E. switch, will be provided under Division 23. The 120V AC wiring will be provided under this section..
11. Voice Evacuation Speaker/Strobe units shall be UL listed for use in voice evacuation systems. Audible and visual indications shall operate independently or in unison.
12. Animal Care Facilities
    a. Provide “Silentone” horns or approved equal throughout all animal care facilities. Provide red lensed strobe in animal holding rooms.
    b. Provide speakers in the office areas of the animal facility.

M. Voice Evacuation System:
1. The Contractor shall provide all work required for installation of a Voice Evacuation System for the buildings indicated by the drawings. Scope of this Contractor's work will be as described by this section of the specifications and as shown on the drawings.
2. Buildings that are defined as high rise shall have the following: An Audible Alarm on the floor where that event is detected and a general message to all other floors stating, “ A fire Alarm has been detected on (indicate floor number). Remain alert and evacuate if there are indications of fire.

O. Voice Evacuation System:
1. The Contractor shall provide all work required for installation of a Voice Evacuation System for the buildings indicated by the drawings. Scope of this Contractor's work will be as described by

this section of the specifications and as shown on the drawings.

2. Buildings that are defined as high rise shall have the following: An Audible Alarm on the floor where that event is detected and a general message to all other floors stating, " A fire Alarm has been detected on (indicate floor number). Remain alert and evacuate if there are indications of fire. If no danger is noted, you may await further instruction. Elevators have been recalled to level 1(or alternate floor if the fire alarm is on level 1) until the fire alarm is over."
3. Fire Alarm Voice Evacuation Panel (FVEP):
   a. The FVEP shall be located in conjunction with the FACP and shall provide evacuation signals, pre-recorded fire alarm messages, and one-way communication (paging) on a selective.
   b. FVEP equipment shall include the following:
      1) Voice paging, hand-held, push-to-talk microphone with dynamic noise canceling.
         Frequency response shall be flat within + 3 dB from 200 to 5,000 Hz.
      2) Zone paging selector switches and LED's, with one selector switch and two LED's provided for each speaker zone.
      3) "Manual Fire Evacuation Tone" switch and LED.
      4) "Silencing" fire evacuation tones (self-restoring switch) and LED.
      5) "Pre-recorded Message" switch and LED.
      6) "All Call", switch and LED, with the switch enabling the operator to simultaneously page all speaker zones on both risers.
      7) Reset switch.
      8) Lamp test switch.
      9) "Page" LED, which will light when the paging microphone is used.
      10) The FVEP shall also be equipped with LED's to indicate trouble conditions for the following:
         a) Each individual speaker zone.
         b) Amplifier, preamplifier, fire tone, pre-recorded messages, and voices paging.
      11) All switches and LED's shall be clearly identified with engraved labels.
      12) Each group of LED's shall have distinctive colors, such as:
         a) Fire Tone -
         Red b) Silence -
         Yellow c) Page -
         Green
         d) Trouble - Yellow
         e) Pre-recorded Message - Red
   c. The fire evacuation signal shall be applied to any specific zone automatically from the FACP or FACT, or shall be selected manually by the speaker zone switch.

4. FVEP Audio Cabinet:
   a. 100% redundant tone generators, preamplifiers, and amplifiers shall be provided.
   b. The audio trunk shall be electronically supervised and shall be automatic switchover from one audio signal path to the other.
   c. Each amplifier module shall be provided with two 40-watt amplifiers, and shall power a minimum of 8 speaker zones.
   d. Pre-recorded message shall be programmed and recorded in a memory chip. Tape cassette players are not acceptable.
   e. The FVEP audio cabinet shall be capable of remote "All Page" activation via local microphone from the University Police Station. The system shall allow the selection of individual building or "All" buildings for "Disaster Messages".
   f. Provide capability of testing and adjusting audio amplifier outputs. Provide test switch at the FACP.

P. Spare Parts: Refer to Section 01 78 46 – Extra Stock Materials.

PART 3 - EXECUTION

3.1 INSTALLATION – FIRE ALARM

A. Fire Alarm layouts:
1. General:
a. Provide a fire alarm system for each building.
1) Actual detection required per building shall be determined by National codes, Local codes and the university CBO, whichever is more stringent.
b. Provide shunt trip circuit breaker for connection to elevators with sprinkle red shafts.

2. Regardless of building occupancy rating, the following areas shall be provided with detection:
a. Laboratories
b. Electrical Rooms
c. Mechanical Rooms
d. Telecommunications Rooms
e. Data Centers
f. Dedicated Storage Rooms
g. Kitchens

3. In general, the following type of detection shall be provided in each type of room:
a. Photoelectric Smoke Detection:
1) Electrical/Telecommunication Rooms
2) Office Corridors (except where sprinkled)
3) Offices (except where sprinkled)
4) Laboratories
5) Mechanical Ducts
6) Elevator Shafts/Machine Rooms
7) Dedicated Storage Rooms
8) Linear Equipment Rooms
b. Thermal Detection:
1) Restrooms
2) Mechanical Rooms
3) Kitchens/Break rooms
4) Environmental Services (Janitor) Rooms
5) Elevator Shafts/Machine Rooms
6) Generator Rooms
7) Autoclaves
c. Flame Detection:
1) Generator Rooms
4. Provide control module at each access control panel for interface with access control system.

B. Installation shall be supervised and tested by the manufacturer of the system equipment.

C. Low Voltage/Wire and Cable: All LV/W&C shall be run in conduit in floors, walls and non accessible spaces. In hallways, LVW/C can be run in bridle rings attached to the common telecom and other low voltage system cable tray. LV/W&C must be run in a conduit sleeve, minimum 2” dia. with plastic bushings, from the point it leaves the bridle ring on the cable tray to the interior side of a room. Once the LV/W&C enters the room it can be supported from bridle rings or j-hooks. Wiring shall comply with Division 27 and approved NEC.

D. Low Voltage/Wire and Cable and Hallway Devices: LV/W&C running from the cable tray to devices in the hallway shall be protected by plenum rated flexible sleeving or flexible metal conduit. LV/W&C in

sleeving or flexible metal conduit shall be supported per NEC and installed with UL approved connectors and plastic bushings on both ends.

E. Outlet pull and junction boxes shall be painted red on the exterior. F. Devices: Locate devices per ADA standards.

G. In construction areas where there is existing equipment, the equipment must be protected during construction and the devices taken off line to eliminate false alarms. All devices associated with modifications to an existing.

H. Contractor is liable for damage. The university must be notified at the completion of each project to ensure that the system is returned to normal.

I. If room numbers are changed or new room numbers established, the University Project Manager must be notified before implementation so that the system can be re-programmed and is accurate in the event of an alarm.

J. All devices mounted in ceiling tile to be supported by T-bar hanger bracket and appropriate box. Plaster ring is not acceptable.

K. Labeling:
1. Observe the university fire alarm color code guide.
2. Label each splice with correct information.
3. Label each initiating device with correct device address. Use Kroy labeler or equal.
4. Final, correct university room numbers (not design/construction room numbers) must be provided for correct programming.
5. All detectors to have factory dust covers installed until after the final inspection and clean up is complete.
6. All duct detectors to have individual remote LED/test stations installed. Mount at 6'-0" AFF in main corridor adjacent to area served. Label as directed by the University Project Manager.
7. All shielded wiring to be bonded together at each device and insulated from contact with the conduit or box.
8. All equipment and associated wiring removed from service will be returned to the University Project Manager for proper disposal.
9. Avoid locating detectors above countertops and/or shelving.
10. Locate detectors at least eight feet from supply or return air diffusers.
11. Use fixed heat detectors near autoclaves and steam sterilizers.
12. Mount remote lights for room detectors above door to corridor, centered.

L. Construction Requirements:
1. Integrity of Structure: Do not drill or pierce structural members without prior approval from the University Project Manager and Structural Engineer.
2. Penetration of Walls, Etc.: Fire caulks or seal all penetrations made through walls, floors, and ceilings around the conduit. Maintain the integrity of fire ratings within the structure. Where visible, paint to match surface.
3. Wherever possible, install conduits and raceways in a concealed manner, except at surface-mounted cabinets.
4. Access to Existing Facilities: Install all conduit and pull boxes to maintain or provide access to existing valves; covers to existing pull boxes; wire ways or access doors; electrical outlets; switches; motors, etc.
5. Support bridle rings/"J" Hooks independently from structure, may have separate point of attachment to cable tray.
6. No other wiring or systems to be installed with fire alarm.
7. The addition or removal of any walls, doors, or other floor plan modifications will require the contractor to update the FACT graphics and graphic map at the FACP.

M. Prior to start of construction, disable existing fire alarm devices, as necessary. A minimum of two working days notice, prior to construction, shall be coordinated through the University Project Manager.

3.2 TESTING, CLEANING AND CERTIFICATION

A. When installation is complete, system shall be tested in accordance with NFPA72 requirements. A representative of the system manufacturer shall submit a written report of the findings to the A/E with copy of to the FD. System testing shall include, at the least, verifying the following:
   1. The functional operation of each re-settable initiating device (manual stations, detectors, etc.) and circuit.
   2. All notification appliances shall be tested for a minimum of ten minutes under normal alarm conditions.









3. The functional operation of each and every alarm device and circuit.
4. The functional operation of each monitored device circuit.
5. The functional operation of each control circuit, including fan controls.
6. The supervision functions of each initiating, indicating, monitoring, control and supply circuit.
7. Control station automatic signaling.
8. That all software protocol, access codes and operation instructions have been supplied.
9. All installed or modified fire alarm systems for remodels or new projects shall be tested and certified by a Factory Representative. Upon a system test completion a "Letter of Certification" shall be issued to the university.

B. All testing and verifications shall be conducted in the presence of the university Facilities Operations Fire and Safety personnel.

C. There shall be an operational test by the FD.

3.4 COMMISSIONING (DEMONSTRATION)

A. The equipment supplier shall provide a minimum of 8 hours of system training for the university Facilities Operations personnel training for each new system.

PART 4 – CHANGE LOG

3/8/2021	1. Updated pre-approved distributor/installer list, added FAS. 2. Added 3.1 L 7 – FACT and graphic map update requirements. 3. Corrected various section numbering.
12/29/2020	1. Updated approved installer Systems Group and added ADT.

END OF SECTION 28 31 00

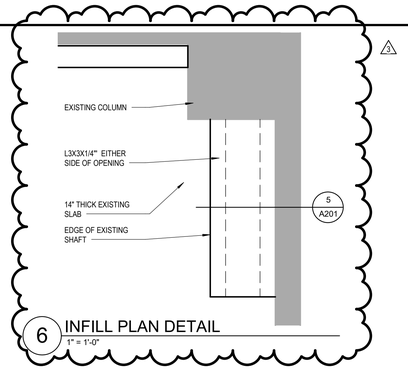

6 INFILL PLAN DETAIL
1" = 1'-0"

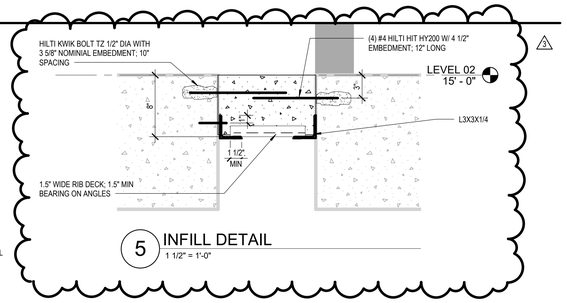

5 INFILL DETAIL
1 1/2" = 1'-0"

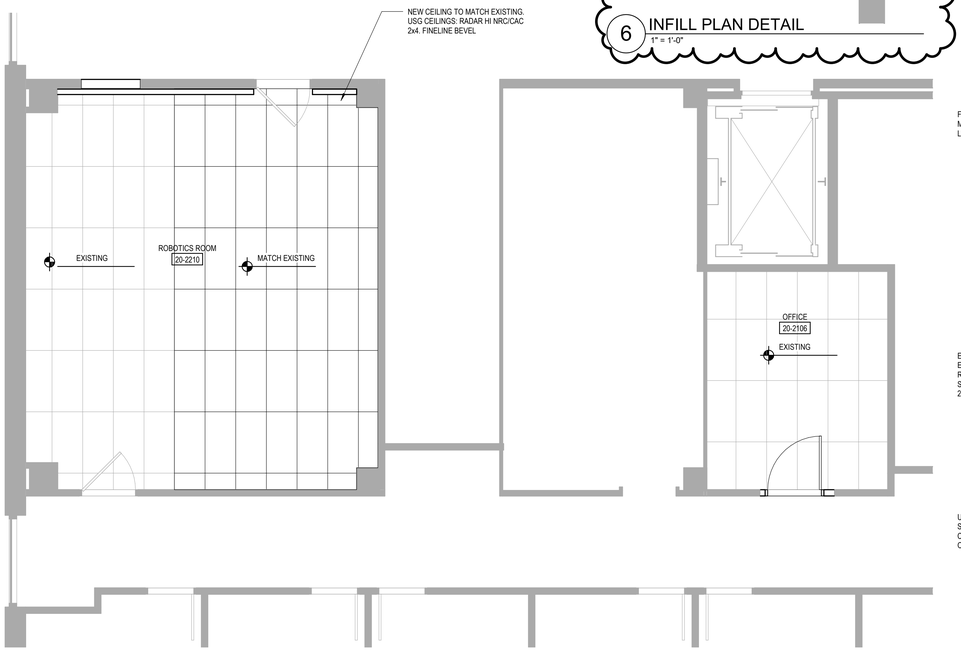

4 CEILING PLAN - LEVEL 02
1/4" = 1'-0"

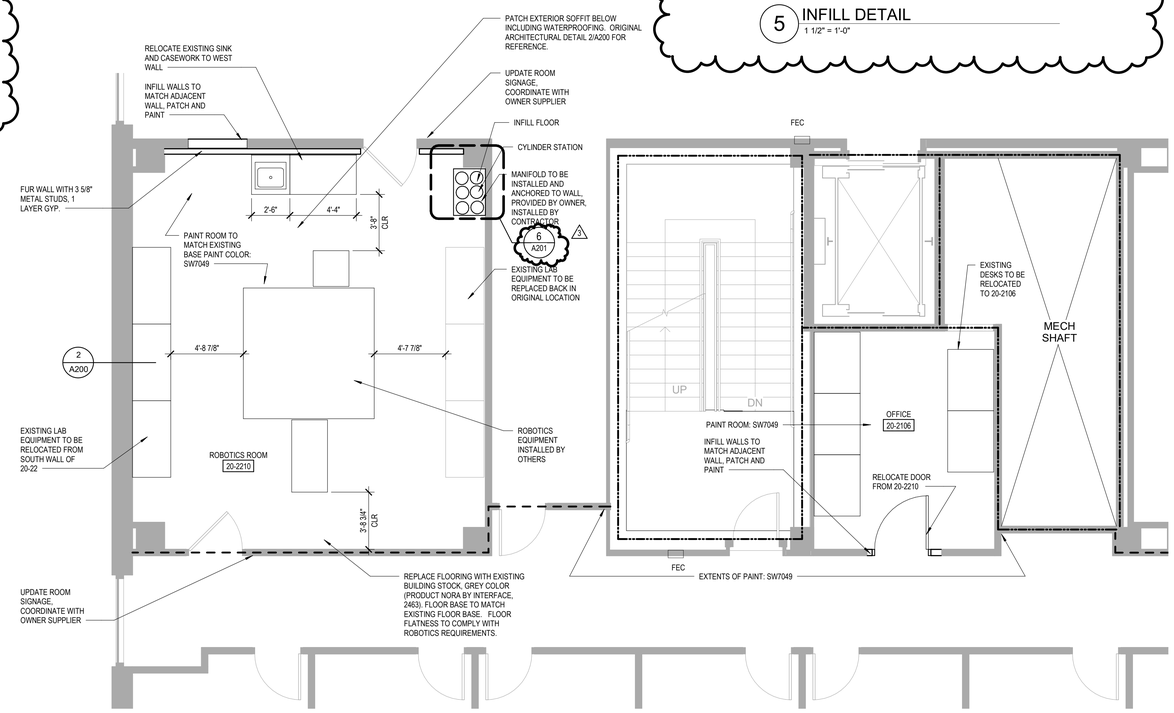

2 FLOOR PLAN - LEVEL 02 - ROBOTICS ROOM
1/4" = 1'-0"

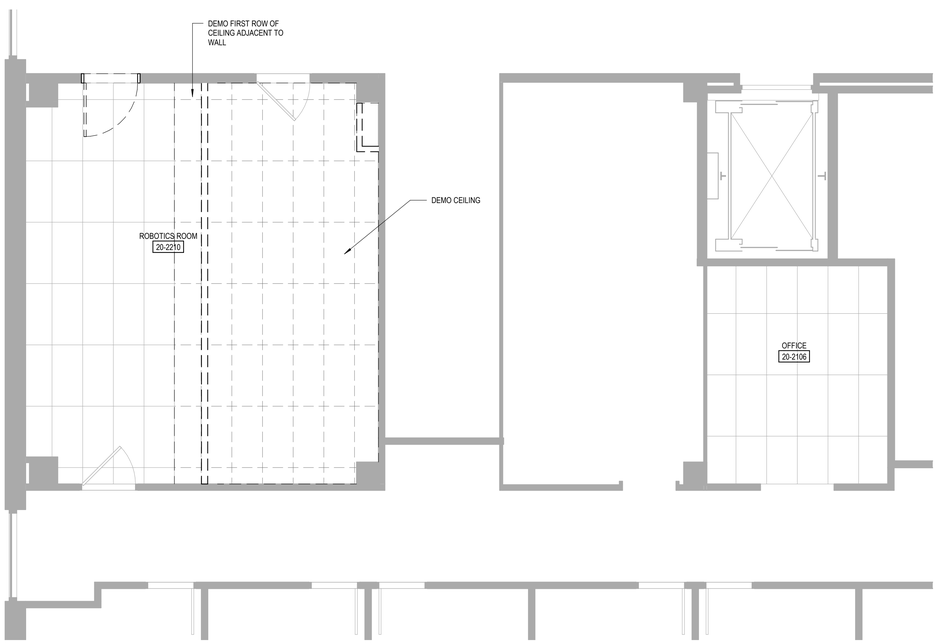

3 DEMO CEILING PLAN - LEVEL 02
1/4" = 1'-0"

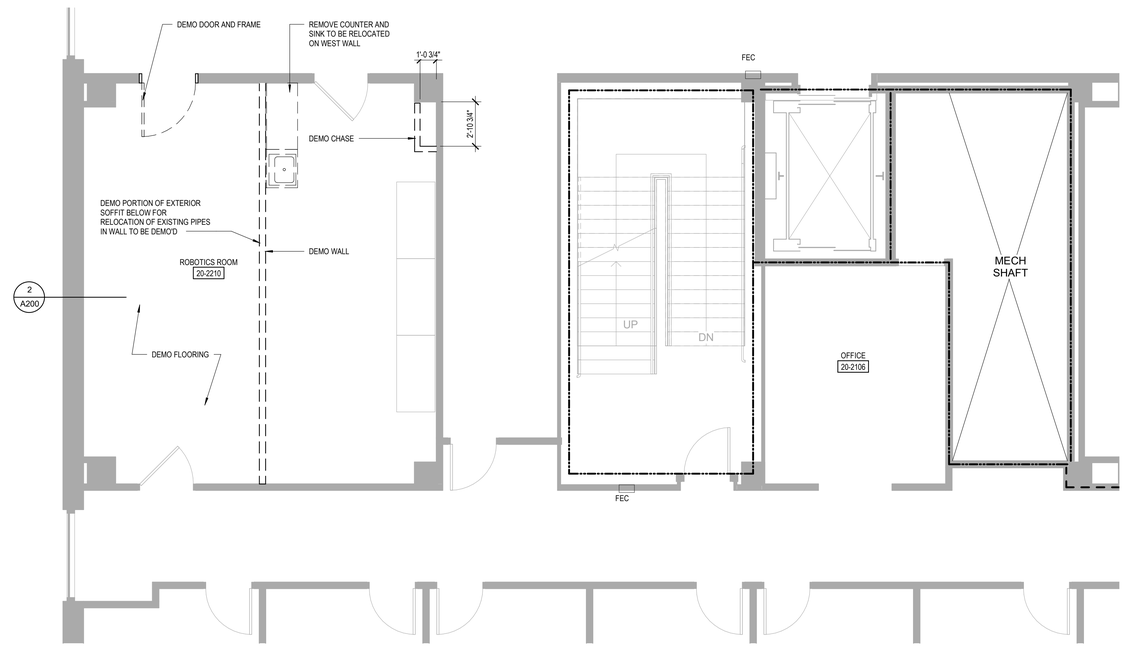

1 FLOOR PLAN - LEVEL 02 - ROBOTICS ROOM
DEMO PLAN
1/4" = 1'-0"

University of Colorado
Anschutz Medical Campus

Project
CU Anschutz - G3 Robotics Lab Renov
1635 AURORA CT,
AURORA, CO 80045

Prepared For
University of Colorado

Anchutz Medical Campus

Hellmuth, Obata + Kassabaum, Inc.
10 South Broadway, Suite 200
St. Louis, MO 63102 USA
t +1 314 421 2000 f +1 314 421 6073

All reproduction & intellectual property rights reserved © 2015

In Association with
ME ENGINEERS
14143 Denver West Pkwy, Suite 300 Golden CO 80401
office: +1 303.421.6655

Key Plan

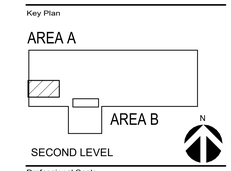

SECOND LEVEL

Professional Seals

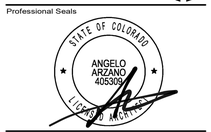

No.	Description	Date
1	ADDENDUM 02/% FOR CONSTRUCTION	1-20-2111

Project No: 20.01058.00

Sheet Title
ROBOTICS ROOM

Original drawing is 42 x 30 Do not scale contents of this drawing

Sheet Number
A201

2021-03-12 11:10:14 AM B:\Revit Projects\20.01058.00 CU Anschutz - G3 Robotics Lab Renov\CUAnschutz-HOK-AR-Central.rvt_Allison.Johnson_20210312.rvt

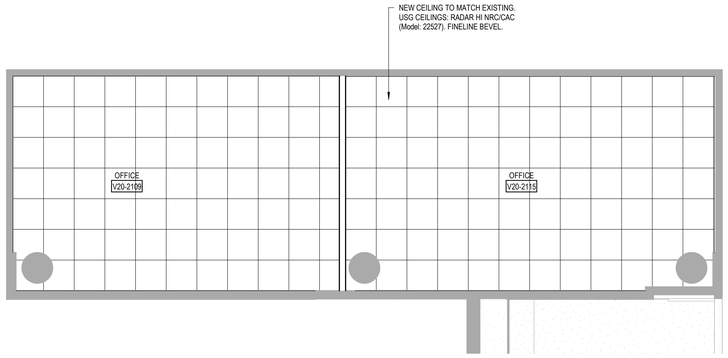

4 CEILING PLAN - LEVEL 02 ROOM V20-2109
1/4" = 1'-0"

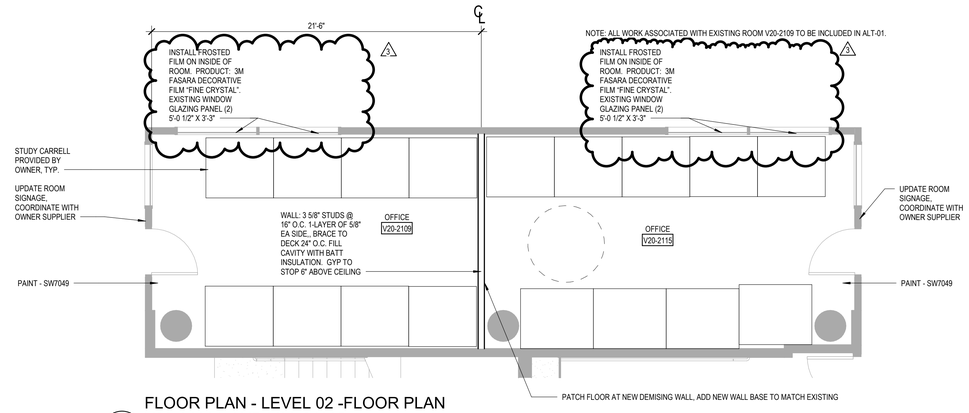

2 FLOOR PLAN - LEVEL 02 -FLOOR PLAN
V20-2109A AND V20-2109B
1/4" = 1'-0"

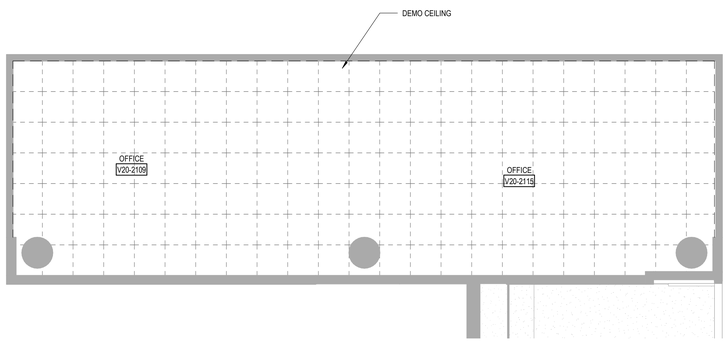

3 DEMO CEILING PLAN - LEVEL 02 ROOM 20-2019
1/4" = 1'-0"

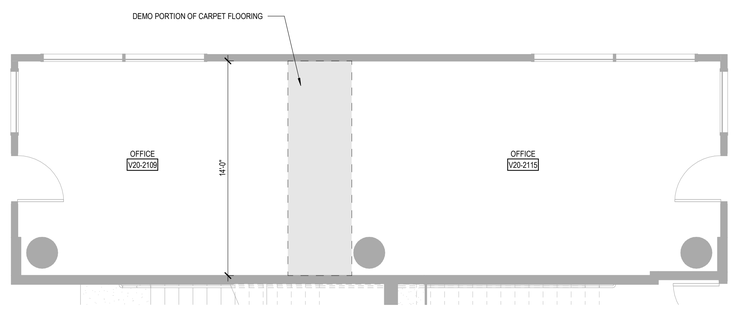

1 FLOOR PLAN - LEVEL 02 -DEMO PLAN
V20-2109A AND V20-2109B
1/4" = 1'-0"

University of Colorado
Anschutz Medical Campus

Project
CU Anschutz - G3 Robotics Lab Renov
1635 AURORA CT,
AURORA, CO 80045

Prepared For
University of Colorado

Anchutz Medical Campus

Hellmuth, Obata + Kassabaum, Inc.
10 South Broadway, Suite 200
St. Louis, MO 63102 USA
t +1 314 421 2000 f +1 314 421 6073

All reproduction & intellectual property rights reserved © 2015

In Association with

ME ENGINEERS
14143 Denver West Pkwy, Suite 300 Golden CO 80401
office: +1 303.421.6655

Key Plan

AREA A

AREA B

N

SECOND LEVEL

Professional Seals

STATE OF COLORADO
ANGELO ARZANO
405309
LICENSED ARCHITECT

No.	Description	Date
1	ADD100% FOR CONSTRUCTION	1-20-21
2	ADDENDUM NO. 1	02-19-21
3	ADDENDUM NO. 2	03-12-21

Project No: 20.01058.00

Sheet Title

RESEARCH - ALT-01

Original drawing is 42 x 30. Do not scale contents of this drawing

Sheet Number

A202

2021-03-12 11:15:23 AM B:\Revit Projects\20.01058.00 CU Anschutz - G3 Robotics Lab Renov\CUAnschutz-HOK-AR-Central.rvt_Allison.Johnson_20210312.rvt

GENERAL MECHANICAL CONTRACT REQUIREMENTS:

GENERAL:

1. UNLESS OTHERWISE NOTED, THE WORK DESCRIBED ON THE PLANS AND SPECIFICATIONS SHALL INCLUDE THE FURNISHING AND INSTALLATION OF ALL LABOR AND MATERIALS NECESSARY FOR COMPLETE AND OPERATIONAL HVAC, FIRE PROTECTION AND PLUMBING SYSTEMS. CONTRACTOR SHALL FURNISH THESE EVEN IF ITEMS REQUIRED TO ACHIEVE THIS (I.E. OFFSETS, ISOLATION AND BALANCING DEVICES, MAINTENANCE CLEARANCES, ETC.) ARE NOT SPECIFICALLY SHOWN.

2. DATA GIVEN ON THE DRAWINGS IS AS EXACT AS COULD BE SECURED. ABSOLUTE ACCURACY IS NOT GUARANTEED AND THE CONTRACTOR SHALL OBTAIN AND VERIFY EXACT LOCATIONS, MEASUREMENTS, LEVELS, SPACE REQUIREMENTS, POTENTIAL CONFLICTS WITH OTHER TRADES, ETC. AT THE SITE AND SHALL SATISFACTORILY ADAPT HIS WORK TO THE ACTUAL CONDITIONS OF THE JOB.

3. THE DRAWINGS ARE DIAGRAMMATICAL IN NATURE AND SHALL NOT BE SCALED. THEY SHOW CERTAIN PHYSICAL RELATIONSHIPS WHICH MUST BE ESTABLISHED WITHIN THE DIVISION 21,22 AND 23 WORK AND ITS INTERFACE WITH OTHER WORK. ESTABLISHING THIS RELATIONSHIP IN THE FIELD IS THE EXCLUSIVE RESPONSIBILITY OF THE CONTRACTOR. THIS DIVISION SHALL COORDINATE ITS WORK WITH ALL DIVISIONS OF THE WORK AND ADJUST ITS WORK AS REQUIRED BY THE ACTUAL CONDITIONS OF THE PROJECT.

   A. THE CONTRACTOR SHALL VISIT THE SITE BEFORE SUBMITTING A BID TO BECOME THOROUGHLY FAMILIAR WITH THE ACTUAL CONDITIONS OF THE PROJECT. NO EXTRAS WILL BE ALLOWED DUE TO LACK OF KNOWLEDGE OF EXISTING CONDITIONS.

   B. CERTAIN SYSTEMS REQUIRE ENGINEERING OF INSTALLATION DETAILS BY CONTRACTOR. UNLESS FULLY DETAILED IN THE CONTRACT DOCUMENTS, SUCH ENGINEERING IS THE EXCLUSIVE RESPONSIBILITY OF THE CONTRACTOR.

   C. IT IS THE CONTRACTOR'S RESPONSIBILITY TO DETERMINE WHERE CLEARANCES ARE LIMITED, AND WHERE INSTALLATION DRAWINGS OR SCHEMATICS, "CONSTRUCTION DRAWINGS", OR COORDINATION DRAWINGS MAY BE REQUIRED IN ACCORDANCE WITH, OR IN EXCESS OF, THOSE REQUIRED BY THE SPECIFICATIONS. THE CONTRACTOR SHALL PREPARE ALL SUCH COORDINATION DRAWINGS AS PART OF THE BASE CONTRACT. SUCH DRAWINGS MAY BE SUBMITTED TO THE ARCHITECT/ENGINEER FOR RECORD AND COMMENT. ANY WORK INSTALLED WITHOUT APPROVED COORDINATION DRAWINGS IS DONE AT THE CONTRACTOR'S RISK.

4. THESE NOTES ONLY SUPPLEMENT, AND DO NOT REPLACE, THE SPECIFICATIONS.

5. DEFINITIONS AND TERMINOLOGY

   A. THE DEFINITIONS OF DIVISION 1 AND THE GENERAL CONDITIONS OF THIS SPECIFICATION ALSO APPLY TO THE DIVISION 21,22 AND 23 CONTRACT DOCUMENTS.

   B. "CONTRACT DOCUMENTS" CONSTITUTE THE DRAWINGS, SPECIFICATIONS, GENERAL CONDITIONS, PROJECT MANUALS, ETC., PREPARED BY ENGINEER (OR OTHER DESIGN PROFESSIONAL IN ASSOCIATION WITH ENGINEER) FOR CONTRACTOR'S BID OR CONTRACTOR'S NEGOTIATIONS WITH THE OWNER. THE DIVISION 21,22 AND 23 DRAWINGS AND SPECIFICATIONS PREPARED BY THE ENGINEER ARE NOT CONSTRUCTION DOCUMENTS.

   C. "CONSTRUCTION DOCUMENTS", "CONSTRUCTION DRAWINGS", AND SIMILAR TERMS FOR DIVISION 21,22 AND 23 WORK REFER TO INSTALLATION DIAGRAMS, SHOP DRAWINGS AND COORDINATION DRAWINGS PREPARED BY THE CONTRACTOR USING THE DESIGN INTENT INDICATED ON THE ENGINEER'S CONTRACT DOCUMENTS. THESE SPECIFICATIONS DETAIL THE CONTRACTOR'S RESPONSIBILITY FOR "ENGINEERING BY CONTRACTOR" AND FOR PREPARATION OF CONSTRUCTION DOCUMENTS.

   D. "(N)" INDICATES "NEW" EQUIPMENT TO BE PROVIDED UNDER THIS CONTRACT.

   E. "(E)" INDICATES "EXISTING" EQUIPMENT ON SITE WHICH MAY OR MAY NOT NEED TO BE RELOCATED AS A PART OF THIS WORK.

   F. "(R)" INDICATES EXISTING EQUIPMENT TO BE RELOCATED AS PART OF THIS WORK.

   G. "FURNISH" MEANS TO "SUPPLY" AND USUALLY REFERS TO AN ITEM OF EQUIPMENT.

   H. "INSTALL" MEANS TO "SET IN PLACE, CONNECT AND PLACE IN FULL OPERATIONAL ORDER".

   I. "PROVIDE" MEANS TO "FURNISH AND INSTALL".

   J. "EQUIVALENT" MEANS "MEETS THE SPECIFICATIONS OF THE REFERENCE PRODUCT OR ITEM IN ALL SIGNIFICANT ASPECTS." SIGNIFICANT ASPECTS SHALL BE AS DETERMINED BY THE ARCHITECT/ENGINEER.

   K. "WORK BY OTHER(S) DIVISIONS": "RE: XX DIVISION", AND SIMILAR EXPRESSIONS MEANS WORK TO BE PERFORMED UNDER THE CONTRACT DOCUMENTS, BUT NOT NECESSARILY UNDER THE DIVISION OR SECTION OF THE WORK ON WHICH THE NOTE APPEARS. IT IS THE CONTRACTOR'S SOLE RESPONSIBILITY TO COORDINATE THE WORK OF THE CONTRACT BETWEEN HIS/HER SUPPLIERS, SUBCONTRACTORS AND EMPLOYEES. IF CLARIFICATION IS REQUIRED, CONSULT ARCHITECT/ENGINEER BEFORE SUBMITTING BID.

   L. BY INFERENCE, ANY REFERENCE TO A "CONTRACTOR" OR "SUB-CONTRACTOR" MEANS THE ENTITY WHICH HAS CONTRACTED WITH THE OWNER FOR THE WORK OF THE CONTRACT DOCUMENTS.

   M. "ENGINEER" MEANS THE DESIGN PROFESSIONAL FIRM WHICH HAS PREPARED THESE CONTRACT DOCUMENTS. ALL QUESTIONS, SUBMITTALS, ETC. OF THIS DIVISION SHALL BE ROUTED THROUGH THE ARCHITECT TO THE ENGINEER (THROUGH PROPER CONTRACTUAL CHANNELS).

EXISTING BUILDING:

1. THE CONTRACTOR'S ATTENTION IS CALLED TO THE FACT THAT THE EXISTING BUILDING WILL BE OCCUPIED BY THE OWNER DURING CONSTRUCTION. CONTINUED OPERATION OF THE FACILITY SHALL NOT BE HINDERED BY THIS WORK. THE CONTRACTOR SHALL ACCOUNT FOR ALL ADDITIONAL COSTS WHICH MAY BE INCURRED BY HIM DUE TO THE DIFFICULTY OF WORKING OVER AND AROUND EMPLOYEES, DESKS, EQUIPMENT, ETC.; AND DUE TO THE HOURS OF THE DAY IN WHICH AN AREA MAY BE AVAILABLE WHEN SUBMITTING HIS BID.

2. MAINTAIN A MARK-UP SET OF DRAWINGS WHICH INDICATE VARIATIONS IN THE ACTUAL INSTALLATION FROM THE ORIGINAL DESIGN. SURRENDER DRAWINGS TO OWNER UPON COMPLETION.

3. ALL CAPACITIES ARE SCHEDULED AT JOBSITE ALTITUDE OF 5300 FT. ABOVE SEA LEVEL.

4. COORDINATE ALL PENETRATIONS OF THE FLOOR SLAB PRIOR TO COMMENCING WORK UTILIZE X-RAY AND VISUAL INVESTIGATION OF EXISTING CONDITIONS AS REQUIRED PRIOR TO DRILLING OR CUTTING. COORDINATE ALL NEW PENETRATIONS WITH OTHER DIVISIONS OF THE WORK. ALL CONTRACTORS ARE INDIVIDUALLY RESPONSIBLE FOR ALL PENETRATIONS REQUIRED BY THEIR DIVISIONS.

ELECTRICAL COORDINATION:

1. VERIFY THE ELECTRICAL SERVICE PROVIDED BY THE ELECTRICAL CONTRACTOR BEFORE ORDERING ANY MECHANICAL EQUIPMENT REQUIRING ELECTRICAL CONNECTIONS.

2. PROVIDE PREMIUM EFFICIENCY MOTORS WITH 1.15 SERVICE FACTOR ON ALL EQUIPMENT, MOTORS SHALL BE CAPABLE OF OPERATING CONTINUOUSLY AT 105°F UNDER JOBSITE CONDITIONS AND ALTITUDE.

3. UNLESS NOTED OTHERWISE, ALL MECHANICAL EQUIPMENT SHALL BE PROVIDED WITH HOA SWITCH AND STARTER COMPATIBLE WITH EQUIPMENT AND BMS SYSTEM. STARTERS SHALL BE PROVIDED BY DIVISION 21,22 AND 23 UNLESS IN A MOTOR CONTROL CENTER. ALL DISCONNECTS SHALL BE FURNISHED BY DIVISION 26.

4. THE ELECTRICAL POWER FOR CERTAIN EQUIPMENT PROVIDED UNDER DIVISION 21,22 AND 23 HAS NOT BEEN SPECIFICALLY INDICATED ON THE ELECTRICAL DRAWINGS AND MUST BE PROVIDED BY AND FIELD COORDINATED BY THE DIVISION 21,22 AND 23 TRADE REQUIRING SUCH POWER.

   SUFFICIENT POWER FOR THIS PURPOSE SHALL BE FURNISHED AS "SPARE", DEDICATED CIRCUIT CAPACITY IN DIVISION 26'S PANELBOARDS. ALL WIRING, CONDUIT AND ELECTRICAL DEVICES DOWNSTREAM OF THE PANELBOARDS IS THE RESPONSIBILITY OF THE DIVISION 21,22 AND 23 TRADE REQUIRING THE POWER UNLESS OTHERWISE SHOWN ON THE ELECTRICAL DRAWINGS.

   SUCH EQUIPMENT IS HEREBY DEFINED AS:

   A. ELECTRICAL HEAT TRACE. REQUIRED HEAT TRACE LOCATIONS, CAPACITIES AND SPECIFICATION ARE SHOWN OR INDICATED ON THE DRAWINGS. REFER TO SPECIFICATIONS FOR ADDITIONAL INFORMATION.

   B. FIRE PROTECTION AIR COMPRESSORS, DRY-PIPE CONTROL PANELS AND VALVES. REQUIRED CONNECTIONS ARE INCLUDED IN THE DIVISION 21 WORK, AND WILL BE SHOWN BY THAT CONTRACTOR'S ENGINEERED SYSTEM DESIGN DRAWINGS.

      (1) PRE-ACTION SYSTEM INITIATION SIGNALS (SUCH AS SMOKE DETECTORS, OR GENERAL ALARM CONDITIONS IN A PRE-ACTION ZONE) SHALL BE PROVIDED UNDER DIVISION 28 FIRE-ALARM WORK.

      (2) DIVISION 21 SHALL PROVIDE PRE-ACTION CONTROL PANEL AND INTERCONNECTION BETWEEN NEAREST SUITABLE FIRE ALARM PANEL AND LOCATION OF PRE-ACTION VALVE(S).

      (3) DIVISION 28 SHALL PROVIDE INTERCONNECTION BETWEEN FIRE COMMAND CENTER ALARM PANEL (PROVIDED UNDER DIVISION 28) AND REMOTE COMMUNICATION FIRE ALARM PANEL (PROVIDED UNDER DIVISION 28).

   C. TEMPERATURE CONTROL PANELS, CONTROL AIR COMPRESSORS AND LINE VOLTAGE POWER FOR 24V CONTROL TRANSFORMERS. REQUIRED CONNECTION ARE INCLUDED IN DIVISION 230900 AND WILL BE SHOWN BY THAT CONTRACTOR'S CONTROL SUBMITTAL DRAWINGS.

   D. IT IS NOT PERMISSIBLE TO UTILIZE "SPARE" POWER FROM ADJACENT POWER CIRCUITS TO SERVE ANY OF THE ABOVE LOADS. ALL POWER MUST COME FROM DEDICATED CIRCUITS.

5. SMOKE DETECTORS:

   FOR AIR HANDLING UNITS AND AIR SYSTEMS WITH A CAPACITY EXCEEDING 2000 CFM, PROVIDE UL LISTED SMOKE DETECTORS IN RETURN AIR SYSTEMS IN ACCORDANCE WITH THE INTERNATIONAL MECHANICAL CODE AND ELSEWHERE AS SHOWN ON THE DRAWINGS.

   SMOKE DETECTORS WILL BE FURNISHED AND SET IN PLACE UNDER THIS DIVISION. DETECTORS WILL BE WIRED UNDER DIVISION 28. SMOKE DETECTORS MUST BE OF THE SAME MANUFACTURER, AND COMPATIBLE WITH THE FIRE FLARM SYSTEM PROVIDED UNDER DIVISION 28 (IF APPLICABLE).

   CONNECT RELAY(S) TO FAN CONTROL CIRCUIT TO STOP FAN WHEN SMOKE IS DETECTED.

INSTALLATION:

1. SUSPEND EACH TRADE'S WORK SEPARATELY FROM THE STRUCTURE. DUCTWORK SHALL BE HELD TIGHT TO STRUCTURE EXCEPT WHERE OTHERWISE SHOWN.

2. INSTALL ALL EQUIPMENT AND MATERIALS IN ACCORDANCE WITH MANUFACTURER'S RECOMMENDATIONS UNLESS SPECIFICALLY INDICATED OTHERWISE OR WHERE LOCAL CODES OR REGULATIONS TAKE PRECEDENCE.

3. PROVIDE MANUFACTURER'S RECOMMENDED SERVICE CLEARANCE AROUND ALL EQUIPMENT REQUIRING SAME.

4. PROVIDE FOR SAFE CONDUCT OF THE WORK, CAREFUL REMOVAL AND DISPOSITION OF MATERIALS AND PROTECTION OF PROPERTY WHICH IS TO REMAIN UNDISTURBED.

5. PROVIDE ACCESS DOORS FOR ALL EQUIPMENT, VALVES, CLEANOUTS, ACTUATORS AND CONTROLS WHICH REQUIRE ACCESS FOR ADJUSTMENT OR SERVICING AND WHICH ARE LOCATED IN OTHERWISE INACCESSIBLE LOCATIONS.

   A. FOR EQUIPMENT LOCATED IN "ACCESSIBLE LOCATIONS" SUCH AS LAY-IN CEILINGS: LOCATE EQUIPMENT TO PROVIDE ADEQUATE SERVICE CLEARANCE FOR NORMAL MAINTENANCE WITHOUT REMOVING ARCHITECTURAL, ELECTRICAL OR STRUCTURAL ELEMENTS SUCH AS THE CEILING SUPPORT SYSTEM, ELECTRICAL FIXTURES, ETC. "NORMAL MAINTENANCE" INCLUDES, BUT IS NOT LIMITED TO:FILTER CHANGING; GREASING OF BEARINGS; USING P/T PORTS FOR PRESSURE OR TEMPERATURE MEASUREMENTS; SERVICING CONTROL VALVES AND SERVICING CONTROL PANELS.

6. ISOLATE ALL PRESSURIZED PIPE (WATER, ETC.) AT EACH RISER, BRANCH, PIECE OF EQUIPMENT, AND AREA SERVED.

7. NO DOMESTIC WATER, CHILLED WATER, OR HEATING WATER LINES SHALL BE LOCATED EXPOSED IN FINISHED SPACES OR BELOW THE BUILDING SLAB UNLESS SHOWN OTHERWISE ON THE DRAWINGS.

8. WARRANTY: AT A MINIMUM, THE ENTIRE MECHANICAL SYSTEM SHALL BE WARRANTED AGAINST DEFECTS IN MATERIALS AND WORKMANSHIP FOR A PERIOD OF ONE (1) YEAR AFTER ACCEPTANCE OF THE SYSTEM BY THE OWNER. REFER TO INDIVIDUAL SPECIFICATION SECTIONS FOR SPECIFIC WARRANTY REQUIREMENTS.

DUCTWORK INSTALLATION:

1. SEAL ALL SEAMS (LONGITUDINAL AND TRANSVERSE) AIR TIGHT WITH SEALANT PER SPECIFICATIONS.

2. DUCT DIMENSIONS ARE INSIDE CLEAR.

3. DIFFUSER NECK SIZE IS SAME AS FLEXIBLE DUCT SIZE.

4. UNLESS OTHERWISE NOTED, ALL CHANGES IN DIRECTION SHALL BE MADE WITH RADIUS ELBOWS WITH RADIUS TO CENTERLINE EQUAL TO 1.5 DUCT WIDTH.

5. WHERE REQUIRED FOR SPACE CONSTRAINTS, PROVIDE MITERED ELBOWS WITH TURNING VANES AS FOLLOWS:

   A. FOR DUCT WIDTHS OF 36" OR LESS, PROVIDE MANUFACTURED SINGLE WIDTH TURNING VANES, WITH NO TRAILING EDGES AND SPACING IN ACCORDANCE WITH SMACNA DUCT CONSTRUCTION STANDARDS FOR "STANDARD SPACING".

   B. USE DOUBLE THICKNESS (AIRFOIL) BLADES WITHOUT TRAILING EDGES FOR DUCT WIDTHS GREATER THAN 36".

6. ALL FLEXIBLE DUCTS SHALL NOT BE LESS THAN 4', OR MORE THAN 10' IN LENGTH. INSTALL FLEXIBLE DUCTWORK SUCH THAT:

   A. MINIMUM OVERALL LENGTH OF 3D, STRAIGHT INTO NECK OF DIFFUSER.

   B. MAXIMUM OF 135° OF TOTAL TURNING IN ENTIRE LENGTH OF FLEXIBLE DUCT.

   C. MINIMUM TURNING RADIUM OF R = 1.5D.

   D. WHERE:
   * D = FLEXIBLE DUCT DIAMETER
   * R = RADIUS OF TURN AS MEASURED TO CENTERLINE OF DUCT.

8. BRANCH LINES:

   A. MAKE ALL TAPS TO ROUND DUCTWORK WITH CONICAL TEES.

   B. MAKE ALL TAPS TO RECTANGLE DUCTWORK WITH 45° ENTRY OR CONICAL SPIN IN TO ROUND.

   C. INCLUDE DAMPERS AT ALL BRANCH LINES.

9. GREASE DUCTS:

   A. INSTALL AND SLOPE PER BUILDING CODE REQUIREMENTS. IF PERMITTED BY CODE, PROVIDE COLLECTION RESERVOIRS AS REQUIRED FOR LONG HORIZONTAL RUNS.

   B. WRAP IN TWO HOUR RATED FIRE WRAP. COORDINATE WITH ARCHITECTURAL PLANS.

   C. WRAP MUST BE RATED FOR 1,900° F AND HAVE A MINIMUM R VALUE OF 10.

   D. WRAP MUST BE LISTED FOR ZERO CLEARANCE TO COMBUSTIBLES.

10. DUCT SIZES NOT CALLED OUT SHALL BE DETERMINED BASED ON 0.08" S.P. LOSS OR LESS PER 100 FT. OF LENGTH.

11. ASSUME ROUND OR OVAL DUCTS IN EXPOSED AREAS.

12. INCLUDE DAMPERS AT ALL BRANCH LINES, WHERE SHOWN ON THE DRAWINGS, AND WHERE OTHERWISE REQUIRED FOR BALANCING.

PIPE INSTALLATION:

1. ALL PIPING SHALL BE ADEQUATELY SUPPORTED FROM THE BUILDING STRUCTURE TO PREVENT SAGGING, POCKETING, SWAYING OR DISPLACEMENT BY MEANS OF HANGERS AND SUPPORTS. PIPING IS NOT TO BE SUPPORTED BY EQUIPMENT.

2. USE DIELECTRIC WATERWAY FITTINGS WHERE DISSIMILAR METALS ARE CONNECTED.

3. PROVIDE MANUAL AIR VENTS AND CAPPED HOSE-END DRAINS WITH ISOLATION VALVES AT PIPING HIGH AND LOW POINTS.

4. WELD PIPE IN ACCORDANCE WITH APPLICABLE CODES AND STANDARDS. WELDERS SHALL BE CERTIFIED FOR TYPE OF WORK BEING PERFORMED.

5. FLUSH OUT PIPING AND REMOVE CONTROL DEVICES BEFORE PERFORMING PRESSURE TEST. DO NOT USE PIPING SYSTEM VALVES TO ISOLATE SECTIONS WHERE TEST PRESSURE EXCEEDS VALVE PRESSURE RATING. PRESSURIZE PIPING AT 100 PSIG. IF LEAKAGE IS OBSERVED OR IF TEMPERATURE COMPENSATED PRESSURE DROP EXCEEDS 1% OF TEST PRESSURE, REPAIR LEAKS AND RETEST. DO NOT USE AIR PRESSURE TO TEST PLASTIC PIPE.

6. PIPING SIZES SHALL BE BASED ON 2' OR LESS HEAD LOSS PER 100 FEET OF LENGTH. VELOCITIES SHALL NOT EXCEED 10 FEET PER SECOND.

7. INSTALL ALL PIPING TO ALLOW FOR EXPANSION AND CONTRACTION WITHIN THE PIPING SYSTEM. ENSURE ALL REQUIRED PIPE EXPANSION WILL OCCUR IN THE PROPER DIRECTION AND SEGMENT OF PIPE. PROPERLY ANCHOR (RE: SPECIFICATIONS) ALL PIPING REQUIRING EXPANSION/CONTRACTION ISOLATION. COORDINATE PIPE EXPANSION/CONTRACTION TO PREVENT DAMAGE TO ANY AND ALL BUILDING COMPONENTS.

8. PROVIDE ISOLATION VALVES AT EVERY HYDRONIC BRANCH LINE.

CUTTING, PATCHING AND DEMOLITION:

1. KEEP DEMOLITION & CUTTING TO MINIMUM REQUIRED FOR PROPER EXECUTION OF WORK.

2. BE RESPONSIBLE FOR ALL CUTTING AND PATCHING NECESSARY FOR THE COMPLETION OF THE WORK.

3. NO CUTTING (NOT SHOWN ON THE CONTRACT DOCUMENTS) SHALL BE DONE WITHOUT THE APPROVAL OF THE ARCHITECT AS TO LOCATIONS, METHOD AND EXTENT OF THE CUTTING.

4. REPAIR ALL ACCIDENTAL OR INTENTIONAL DAMAGE TO MATCH EXISTING CONSTRUCTION WITH NO NOTICEABLE DIFFERENCE IN CONTINUITY, APPEARANCE OR FUNCTION.

5. ALL "CAPPED" SANITARY AND VENT LINES SHALL BE RECONNECTED OR RE-ROUTED AS NECESSARY TO PREVENT "DEAD-ENDS" IN THE PIPING. ALL PIPING SHALL DRAIN TO ACTIVE SANITARY WASTE LINES AND ALL BRANCHES WITH TRAPS SHALL BE ADEQUATELY VENTED.

GENERAL PLUMBING CONTRACT REQUIREMENTS:

1. THE GENERAL MECHANICAL REQUIREMENTS PERTAIN TO THE WORK OF THIS DIVISION.

2. PREPARE SHOP DRAWINGS OF ALL NEW WORK (INCLUDING SLEEVE LOCATIONS) TO VERIFY LOCATIONS AND COORDINATION OF WORK BETWEEN TRADES PRIOR TO INSTALLATION.

3. ALL DRAIN GRATES, CLEANOUT COVERS, AND OTHER FINISHED, EXPOSED COMPONENTS SHALL BE PROTECTED FROM DAMAGE. DAMAGED COMPONENTS SHALL BE REPLACED BY CONTRACTOR AT NO ADDITIONAL COST TO THE CONTRACT.

4. COORDINATE ROUTING OF ALL PLUMBING PIPING BELOW SLAB WITH STRUCTURAL GRADE BEAMS, TIE BEAMS, ETC. ALLOW FOR REROUTING OF PIPING AS REQUIRED.

5. ALL REQUIRED OPENINGS IN CONCRETE BEAMS AND STRUCTURAL WALLS ARE TO BE ACCOMPLISHED USING SLEEVES PROPERLY SIZED FOR THE PIPE THEY SERVE. CORE DRILLING IN BEAMS IS NOT ALLOWED. CORE DRILLING IN PANS IS ALLOWED UPON PRIOR APPROVAL OF ARCHITECT AND STRUCTURAL ENGINEER.

6. NO DOMESTIC WATER LINES SHALL BE LOCATED EXPOSED IN FINISHED SPACES OR BELOW THE BUILDING SLAB UNLESS SHOWN OTHERWISE ON THE DRAWINGS.

7. WHERE SHOWN, MINIMIZE THE NUMBER OF JOINTS ON ANY PRESSURIZED PIPING BELOW CONCRETE SLABS. ALL BELOW GRADE PIPING TO BE PRESSURE TESTED AND WITNESSED BY ARCHITECT BEFORE BACKFILLING.

8. ALL CLEANOUTS FOR HORIZONTAL STORM DRAINAGE SYSTEM SHALL BE PIPE SIZE OR MAXIMUM 6" FOR LARGER PIPE.

9. IN ADDITION TO THE CLEANOUT LOCATIONS SHOWN ON DRAWINGS, PROVIDE ADDITIONAL CLEANOUTS AT: 3

   A. ALL UPPER TERMINALS.

   B. EACH RUN OF PIPING WHICH IS MORE THAN 100 FEET IN LENGTH OR FRACTION THEREOF.

   C. HORIZONTAL LINES 5 FEET OR MORE.

   D. HORIZONTAL LINES FOR EACH AGGREGATE CHANGE OF DIRECTION EXCEEDING 135 DEGREES.

   E. AT THE BASE OF ALL WASTE AND VENT RISERS. ALL VERTICAL CLEANOUTS SHALL BE SIZED TO ACCOMMODATE THE LARGEST PIPE ON THAT BRANCH LINE, BUT NEVER LARGER THAN 4".

10. NO GAS LINES SHALL BE LOCATED BELOW BUILDING SLAB. ALL GAS PIPING IN AIR PLENUMS TO BE WELDED.

11. PROVIDE ISOLATION VALVES ON ALL PIPING SERVING HOSE BIBBS.

12. ANY ELECTRICAL SPACE NOT CONSTRUCTED WITH A SUB-ROOF WHICH MAY HAVE PLUMBING PIPING AT THE CEILING OF THESE SPACES SHALL HAVE A DRIP PAN INSTALLED BELOW THE PIPING. DRIP PANS SHALL BE 1.5 TIMES THE WIDTH OF THE PIPING SERVED WITH A MINIMUM OF 2" HIGH SIDES. DRIP PANS SHALL BE SUSPENDED FROM THE PIPING SERVED AND SHALL SLOPE AT A MINIMUM 1/8"/FT. DRIP PANS SHALL DISCHARGE WITH MIN. 1-1/2" DR TO FLOOR DRAINS.

   A. DO NOT LOCATE PIPING DIRECTLY ABOVE ANY ELECTRICAL EQUIPMENT IN ELECTRICAL ROOMS.

13. MAINTAIN DESIGNATED PLUMBING FIXTURE HEADER SIZE FOR FULL BANK OF FIXTURES.

STRUCTURE:

1. DO NOT PENETRATE STRUCTURAL MEMBERS. ALL EQUIPMENT SUPPORTS SHALL BE ATTACHED TO THE LOAD BEARING MEMBERS OF STRUCTURAL ELEMENTS. DO NOT OVER-STRESS ANY STRUCTURAL MEMBERS. CONTACT STRUCTURAL ENGINEER FOR ALLOWABLE LOADS FOR SPECIFIC MEMBERS.

2. DO NOT UTILIZE POWER DRIVEN ANCHORS FOR ANY LOCATIONS WHICH REQUIRE THE LOAD TO BE HELD IN TENSION. SEE STRUCTURAL DIVISION FOR ADDITIONAL RESTRICTIONS.

3. SEE ALSO STRUCTURAL DIVISION FOR ACCEPTABLE ANCHORING AND SUPPORT MEANS, METHODS, AND LOCATIONS.

4. PROVIDE FLEXIBLE CONNECTORS, EXPANSION LOOPS, EXPANSION JOINTS, ADDITIONAL FITTINGS OR EQUIVALENT TO ACCOMMODATE THE THERMAL EXPANSION OF THE BUILDING THROUGH STRUCTURAL EXPANSION JOINTS. PROVIDE SUCH FITTING AT EVERY PIPE, DUCT, CONDUIT, ETC. CROSSING OF A STRUCTURAL EXPANSION JOINT.

CONSTRUCTION VENTILATION:

1. WHERE EXISTING OR NEW MECHANICAL SYSTEMS ARE USED FOR TEMPORARY VENTILATION OR CLIMATE CONTROL, MECHANICAL EQUIPMENT INSTALLER SHALL PROVIDE CONSTRUCTION FILTERS, MAINTAIN EQUIPMENT, AND CLEAN, ADJUST AND PUT IN NEW CONDITION BEFORE BUILDING OCCUPANCY. PARTS AND LABOR WARRANTY SHALL NOT BE CONSIDERED TO START UNTIL ACCEPTANCE OF SYSTEM BY OWNER.

2. PROVIDE CONSTRUCTION FILTERS INSTALLED AT ALL AIR MOVING DEVICES THROUGHOUT THE CONSTRUCTION. REMOVE FILTERS ONLY FOR BALANCING AND FINAL TURNOVER. INSPECT ALL NON-CONSTRUCTION FILTERS AND REPLACE ALL THOSE DEEMED NECESSARY BY THE ENGINEER PRIOR TO ACCEPTANCE OF THE SYSTEM BY THE OWNER.

FIRE PROTECTION NOTES:

1. FIRE PROTECTION NOTES

   A. SUBMIT SHOP DRAWINGS SHOWING PROPOSED LAYOUT OF FIRE PROTECTION SYSTEM. DRAWINGS SHALL SHOW ACTUAL EQUIPMENT TO BE USED, DIMENSIONS AND HYDRAULIC CALCULATIONS. SHOP DRAWINGS SHALL BE APPROVED BY THE LOCAL AUTHORITY HAVING JURISDICTION PRIOR TO SUBMITTAL TO ENGINEER OR ARCHITECT.

   B. SHOW THE CONNECTING MAIN AND BRANCH PIPE SIZES FOR ALL RELOCATED EXISTING SPRINKLER HEADS.

   C. CONFORM TO HAZARD OCCUPANCY REQUIREMENTS OF NFPA 13.

2. THE ENTIRE BUILDING SHALL BE SERVED BY A WET PIPE TYPE FIRE SPRINKLER SYSTEM. COORDINATE ELECTRICAL, FIRE PROTECTION AND MECHANICAL SPACE REQUIREMENTS CAREFULLY BEFORE PROCEEDING WITH INSTALLATION.

3. EXTEND THE EXISTING SPRINKLER SYSTEM, RELOCATE EXISTING AND ADD NEW SPRINKLER HEADS IN ACCORDANCE WITH NFPA 13, ALL APPLICABLE CODES AND ORDINANCES AND PROJECT REQUIREMENTS TO COMPLETELY PROTECT THE NEW WORK.

4. SYSTEM SHALL BE INSTALLED COMPLETE AND OPERATIONAL, INCLUDING WATER FLOW INDICATOR, CONNECTIONS TO EXISTING ALARM, DRAIN PIPING, IDENTIFICATION SIGNS, ETC.

5. WORK SHALL BE PERFORMED BY A QUALIFIED FIRE SPRINKLER INSTALLER WITH A MINIMUM OF (5) FIVE YEARS EXPERIENCE IN SIMILAR INSTALLATIONS.

6. COORDINATE ALL WORK WITH ALL OTHER TRADES.

7. SUPPLY OWNER AN EXTRA STOCK OF SIX SPRINKLER HEADS (6), THREE (3) OF EACH TYPE, AND A SPRINKLER WRENCH.

8. PROVIDE TEMPORARY FIRE SUPPRESSION COVERAGE DURING CONSTRUCTION INCLUDING MODIFICATIONS TO EXISTING SYSTEM AND ADDITION OF UP-TURNED SPRINKLER HEADS AS REQUIRED BY BUILDIUNG CODE, NFPA, AND OWNER.

FIRE STOPPING:

1. FIRE STOPPING REQUIREMENT: PENETRATIONS THROUGH RATED WALLS AND FLOORS SHALL BE SEALED WITH A MATERIAL CAPABLE OF PREVENTING THE PASSAGE OF FLAMES AND HOT GASSES WHEN SUBJECTED TO THE REQUIREMENTS OF THE TEST STANDARD SPECIFIC FOR FIRE STOPS ASTM-E-814. ACCEPTANCE MATERIALS NCLUDE: DOW CORNING RTV FIRE STOP FOAM FOR BARE PIPE, METAL CONDUIT, AND ELECTRICAL CABLE; 3M FIRE DAM 21,22 AND 230 CAULK FOR BARE PIPE, METAL CONDUIT, AND BUILDING CONSTRUCTION; GAPS 3M FS-195 INTUMESCENT STRIPS FOR INSULATED PIPES, PLASTIC PIPE OR CONDUIT, AND ELECTRICAL CABLE.

University of Colorado
Anschutz Medical Campus

Project
CU Anschutz - G3 Robotics Lab Renovation
1635 AURORA CT,
AURORA, CO 80045

Prepared For
The University of Colorado

Anchutz Medical Campus

Hellmuth, Obata + Kassabaum, Inc.
10 South Broadway, Suite 200
St. Louis, MO 63102 USA
t +1 314 421 2000 f +1 314 421 6073

All reproduction & intellectual property rights reserved © 2015

In Association with

ME Engineers
14143 Denver West Pkwy, Suite 300 Golden CO 80401
office: +1 303.421.5655

Key Plan

SECOND LEVEL

Professional Seals

COLORADO LICENSED PROFESSIONAL ENGINEER 37026

03.12.2021

No.	Description	Date
1	100% FOR CONSTRUCTION	1-20-21
3	ADDENDUM NO. 2	3-12-21

Project No: 20.01058.00

Sheet Title

MECHANICAL GENERAL NOTES

Original drawing is 42 x 30 Do not scale contents of this drawing

Sheet Number

M001

3/12/2021 11:46:21 AM C:\Revit Projects\2020\CUAnschutz-MEE-MEP20-Central_ian.cuthill-MEE.rvt

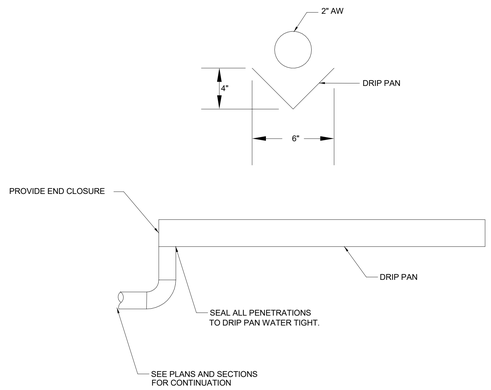

NOTES:
1. DRIP PAN: 24 GAUGE GALVANIZED STEEL. SUPPORT FROM STRUCTURE (DO NOT SUPPORT FROM ANY PIPING). PROVIDE SUPPORT AT 48" MAXIMUM SPACING OR AS NEEDED TO PREVENT EXCESS SAGGING OR SWAYING. SHAPE MAY BE "V", SEMI-CIRCULAR OR RECTANGULAR (WITH CREASE). MATCH SLOPE OF WASTE PIPING.
2. DRAIN LINE: CONNECT DRAIN LINE TO WASTE RISER.

F AW DRAIN PAN

NOT TO SCALE

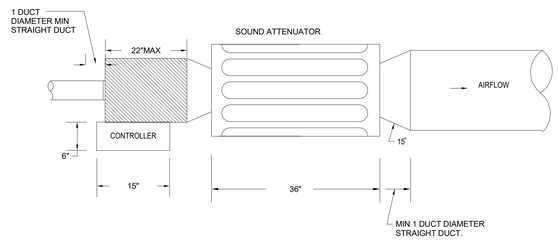

C TYPICAL LAB MODEULE SAV/EAV (SIEMENS TERMINAL)

NOT TO SCALE

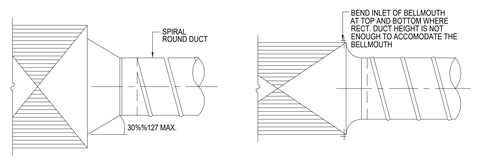

CONICAL BELLMOUTH

NOTES:
1. SECURE ALL CONNECTIONS TO COMPLY WITH THE REQUIREMENTS OF THE PRESSURE CLASS SPECIFIED.
2. SUPPLY ROUND DUCT TAKE-OFF IS SHOWN. RETURN/EXHAUST SIMILAR.
3. "SPIN-INS" PERMITTED ONLY W/DUCT CONSTRUCTION OF 2" W.C. OR LESS.

D ROUND DUCT TAKE-OFF CONNECTIONS TO RECTANGULAR DUCT

NOT TO SCALE

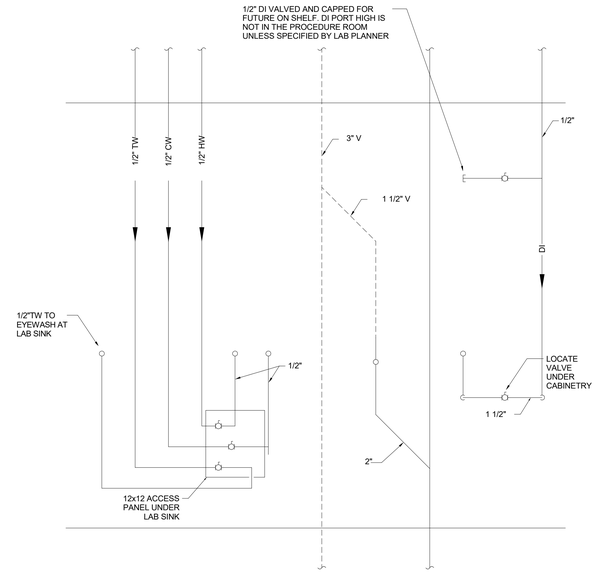

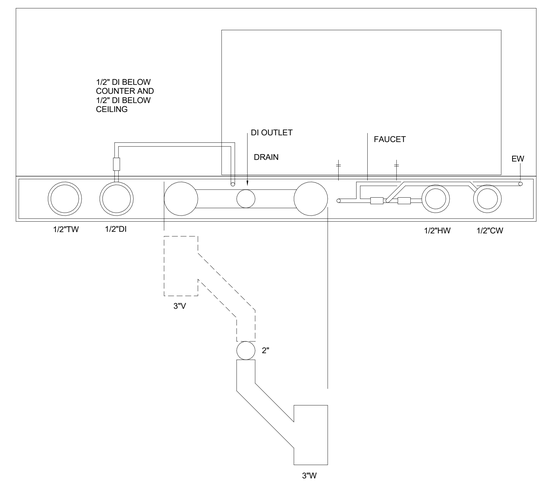

A PIPING AT TYPICAL LAB SINKS

NOT TO SCALE

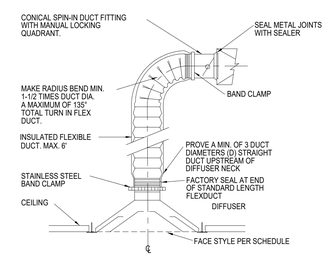

E CEILING DIFFUSER DETAIL

NOT TO SCALE

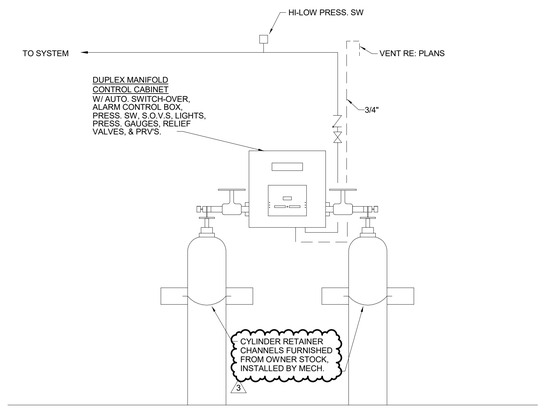

B NITROGEN OR CO2 CYLINDER MANIFOLD

NO SCALE

3/12/2021 11:46:22 AM C:\Revit Projects\2020\CU\Anschutz-MEE-MEP20-Central_Jan.cu\hill-MEE.rvt

University of Colorado
Anschutz Medical Campus

Project
CU Anschutz - G3 Robotics Lab Renovation
1635 AURORA CT,
AURORA, CO 80045

Prepared For
The University of Colorado

Anchutz Medical Campus

Hellmuth, Obata + Kassabaum, Inc.
10 South Broadway, Suite 200
St. Louis, MO 63102 USA
t +1 314 421 2000 f +1 314 421 6073

All reproduction & intellectual property rights reserved © 2015

In Association with

ME Engineers
14143 Denver West Pkwy, Suite 300 Golden CO 80401
office: +1 303.421.5655

Key Plan

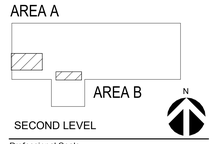

SECOND LEVEL

Professional Seals

03.12.2021

No.	Description	Date
1	100% FOR CONSTRUCTION	1-20-21
3	ADDENDUM NO. 2	3-12-21

Project No: 20.01058.00

Sheet Title

MECHANICAL AND PLUMBING DETAILS

Original drawing is 42 x 30 Do not scale contents of this drawing

Sheet Number

M801